


LEGEND — see dwg. 25-5126-2

SEAL	BY	DATE	No.	REVISION	ENG. No.	DATE	ISSUE
------	----	------	-----	----------	----------	------	-------

B.D.	88-07-20	E	Updated legal information - Pl 46415			
BD	87-10-07	D	Added connection info - P Inter WC's			
MM	86-09-05	C	Subdivision & Ref. notes west of Chancellor			
SD	83-05-01	B	Added cadastral information			
J.C.	5-5-81	A	As built			
BY	DATE	No.	REVISION	ENG. No.	DATE	ISSUE

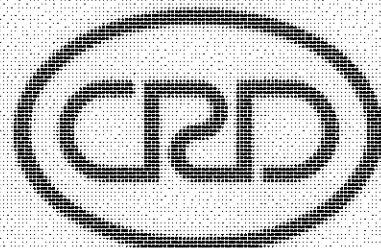

**CAPITAL REGIONAL DISTRICT ENGINEERING**

SURVEYED	UMA	FIELD BOOK No.	VIEW ROYAL SEWERAGE SYSTEM
DESIGNED	S.M.O., TNV	R.E.S. No. 5C78-162	CONTRACT 79-756 — AREA 4
DRAWN	TNV	CONTRACT NUMBER 79-756	Plan & Profile — MH 45 to MH 48
CHECKED	<i>[Signature]</i>	DATE 9 Nov 1979	Portage Inlet Foreshore R/W
APPROVED	<i>[Signature]</i>	SCALE HORIZONTAL 1:500	SCALE VERTICAL 1:100
		DRAWING NUMBER 25-5126-8	ISSUE 1 OF 8