


TCH -120m EAST OF TCH & BURNETT RD

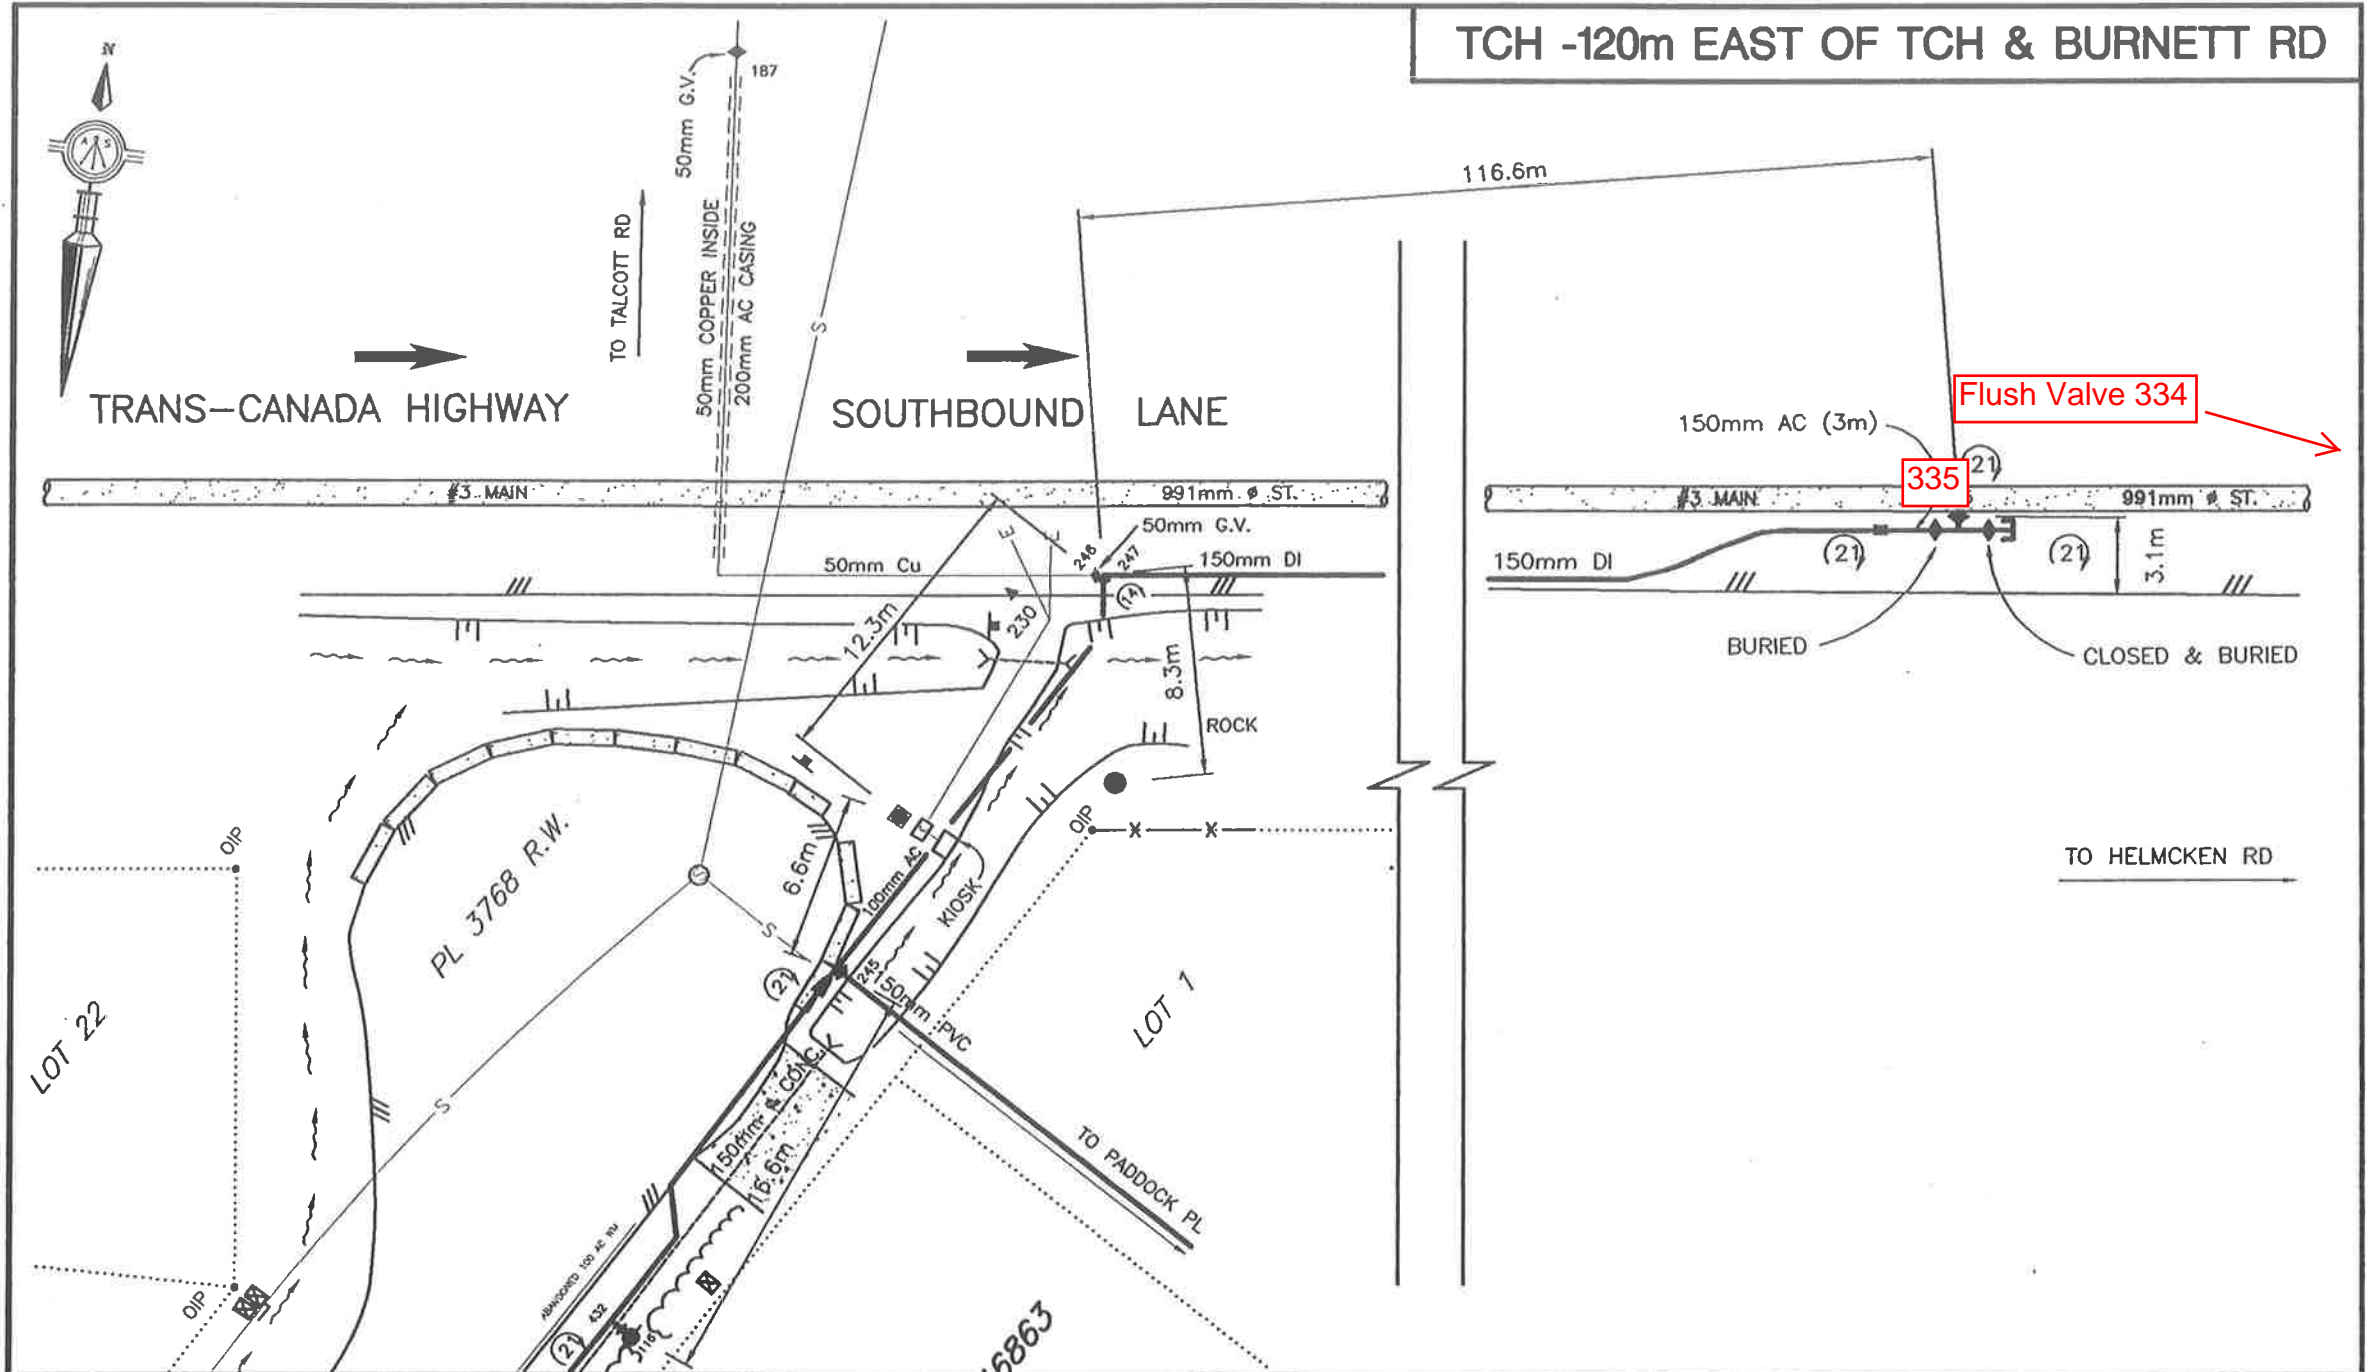

◆ VALVE	⊗ METER BOXES	⌄ SIGN	⊙ SEWER MH	—W— WATER	—H— HYDRO	● IRON PIN	▲ TRAVERSE HUB	⌚ BUSH LINE	DRAWN BY: A.S. FILE: BURNETT \SURVEYS\DIST.MN DATE: AUG 96	SCALE: 1:300 SHEET: 134	
⊕ AIR VALVE	▶ REDUCER	○ MANHOLE	⊙ DRAIN MH	—T— TEL	—G— GAS	● LEAD PLUG	⊙ MONUMENT				
● HYDRANT	⌄ CAP	⊠ LAMP STAND	⊙ HYDRO MH	—S— SEWER	/// ASPHALT	⋯ PROPERTY LINE	● POLE				
● STAND PIPE	⊠ CATCH BASINS	≡ BANK	⊙ TEL MH	—D— DRAIN	⊙ ADDRESS	/// RIGHT OF WAY	⌄ GUY WIRE	⌚ BUSH			
								⌚ FENCE			

ALL UNDERGROUND UTILITY LOCATIONS ARE APPROXIMATE