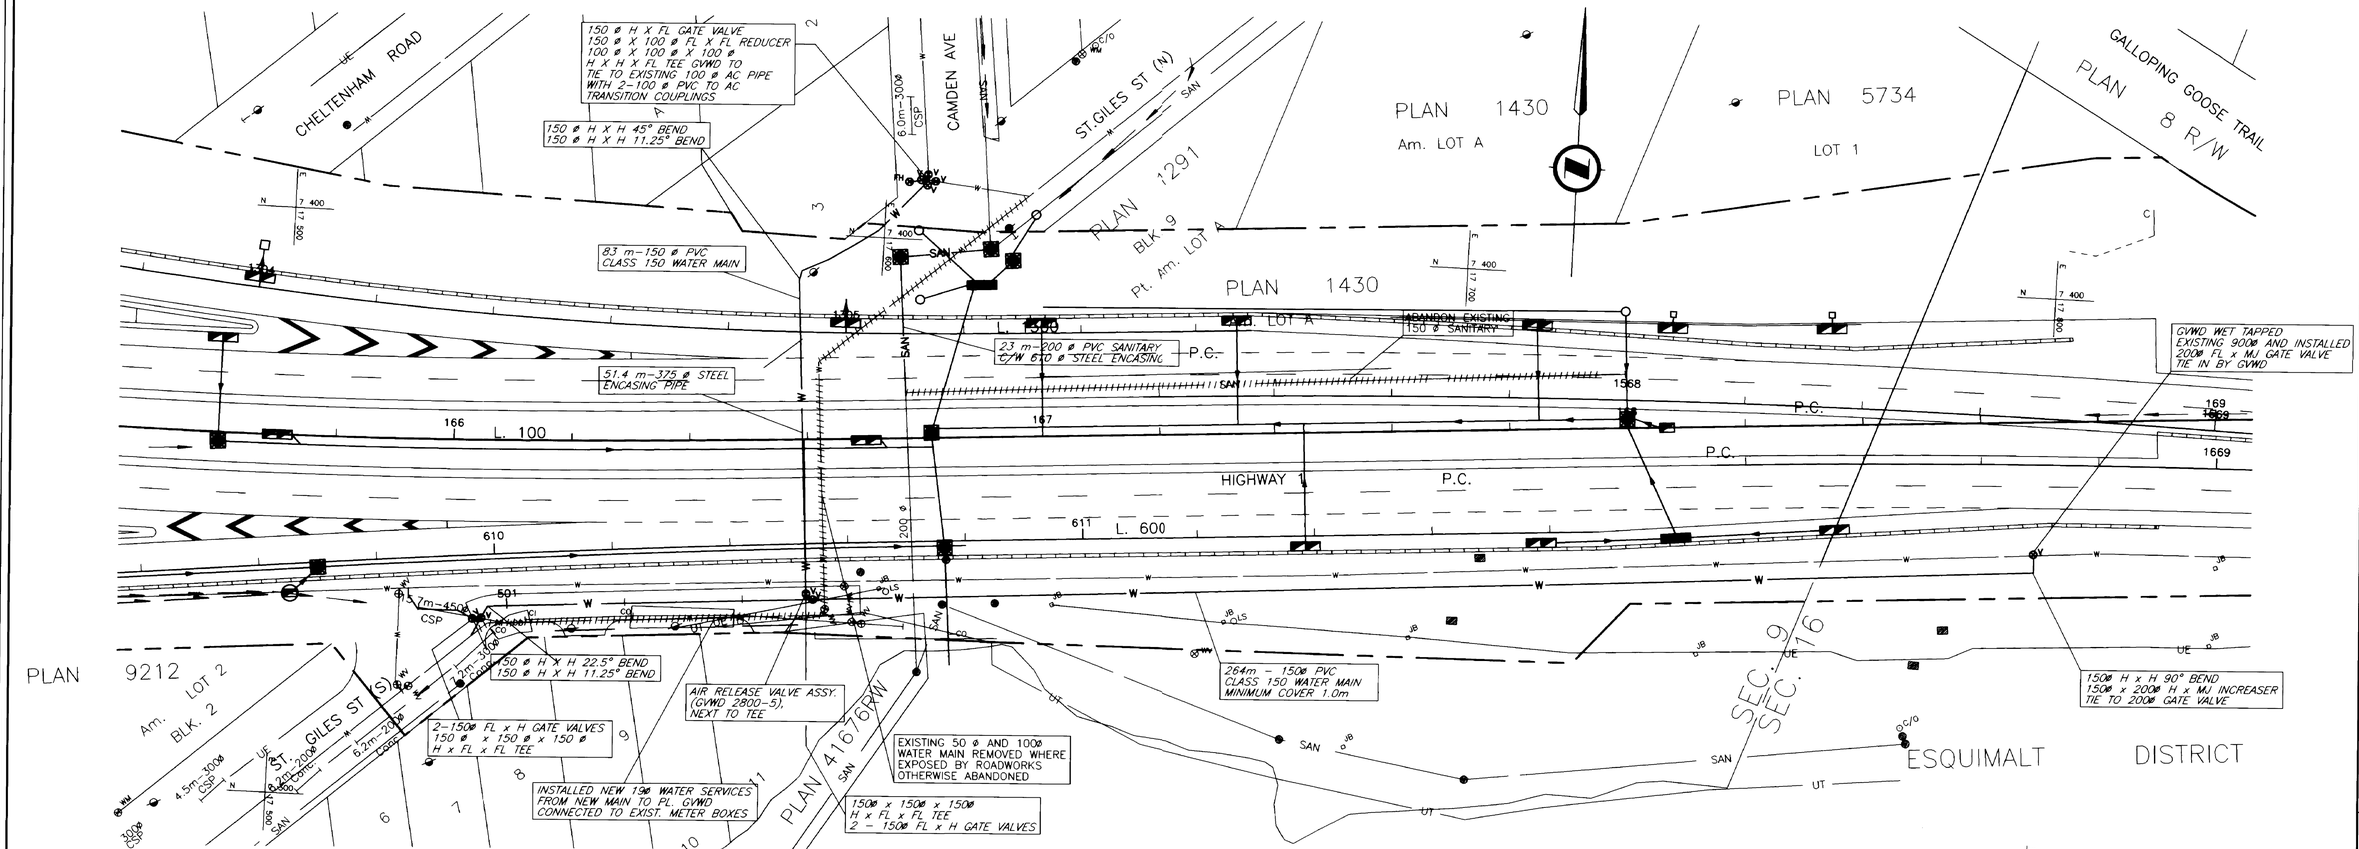

150mm PVC CLASS 150 WATERMAIN STA.166+03.3 O/S 31.9m Rt. to GATE VALVE at STA. 168+68.6 O/S 22.5 Rt.

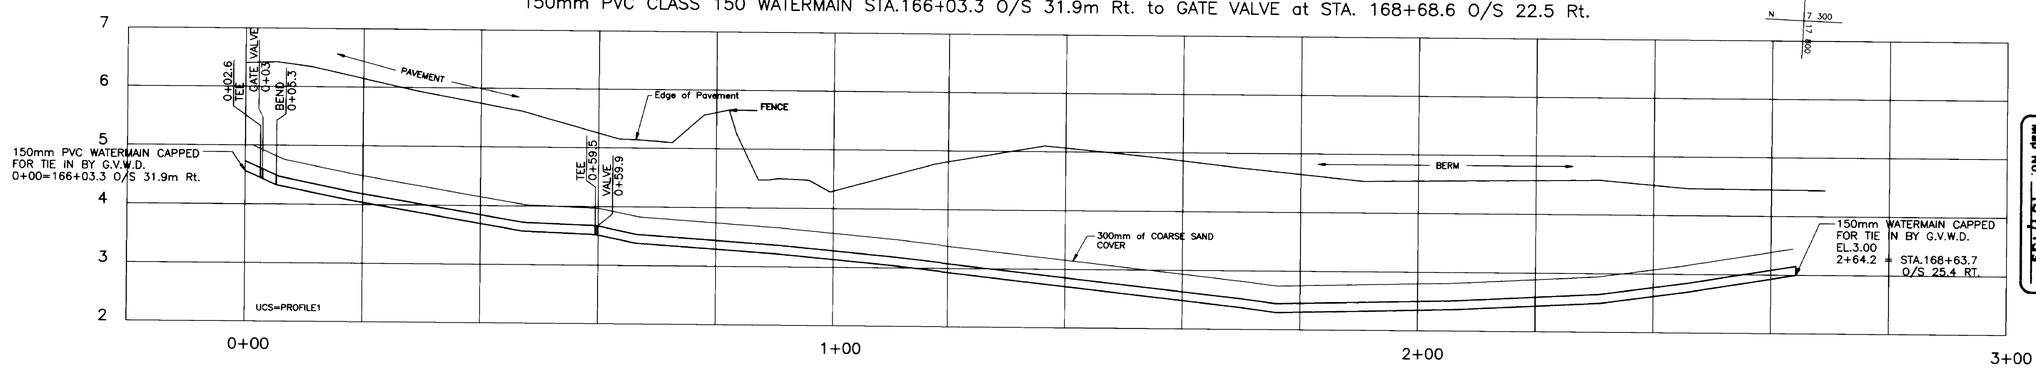

G.V.W.D. Dwg. No. 3478
File No. 150-40-01-01
Map No. 134/135

150mm PVC CLASS 150 WATERMAIN X-ING @ STA. 166+59.2

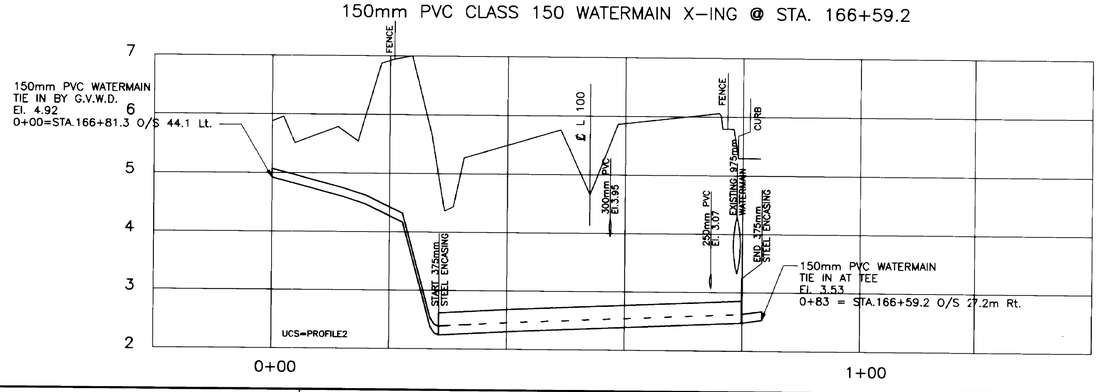

SCALE
Horiz. 1:500
Vert. 1:50
DESIGNED ____ DATE ____
CHECKED ____ DATE ____
DRAWN L.F. DATE JAN '96

Description	Init

REVISIONS

Province of British Columbia
MINISTRY OF TRANSPORTATION AND HIGHWAYS
VANCOUVER ISLAND HIGHWAY PROJECT

AS BUILT 150mm WATERMAIN PLAN/PROFILE
Trans Canada Highway No. 1
ST. GILES AND CAMDEN AVE.

Project Manager: Vancouver Island Highway Project Management Team, 200 - 546 Yates Street, VICTORIA, B.C. V8W 1K8
Design Consultant: ASSOCIATED ENGINEERING
BUILT UNDER THE DIRECTION OF: DON COUCH, PROJECT SUPERVISOR
COMPLETED DEC. 1997

FILE No.	PROJECT No.	CONTRACT No.	REGION	DRAWING No.
L6-01-212	06213	082MJ5330	6	R6-V2124-H562

CANCEL PRINTS BEARING PREVIOUS LETTER

H-308F(02-90)