


I CERTIFY THAT TO THE BEST OF MY KNOWLEDGE THE FOLLOWING SERVICES:
SEWER
WERE INSPECTED DURING CONSTRUCTION AND INSTALLED IN ACCORDANCE WITH MUNICIPAL SPECIFICATIONS AND AS SHOWN ON THESE DRAWINGS.

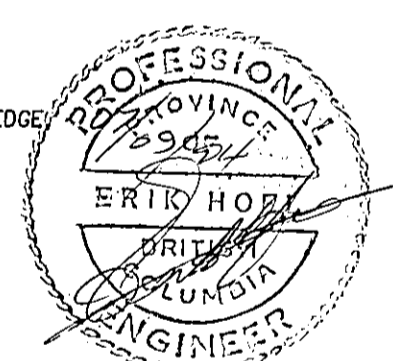

HOEL ENGINEERING LTD.
104-4475 VIEWMONT AVE TEL 479 2224
VICTORIA BC FAX 479 6046

VIEW ROYAL DWG NO. VR94-5-2				SHEET 2 OF 2	
TOWN OF VIEW ROYAL					
TALCOTT ROAD					
AS-CONSTRUCTED					
B.M.	80H3085	WEST BURNSIDE AT #1471	ELEV.	27.652m	DESIGN DWT/ERSKINE/OS-AB3.DWG
DESIGN		DRAWN FC	CHECKED		FILE
SCALES	Hor. 1:500	Vertical 1:100	DATE	MAR 18 1994	DWG. No.