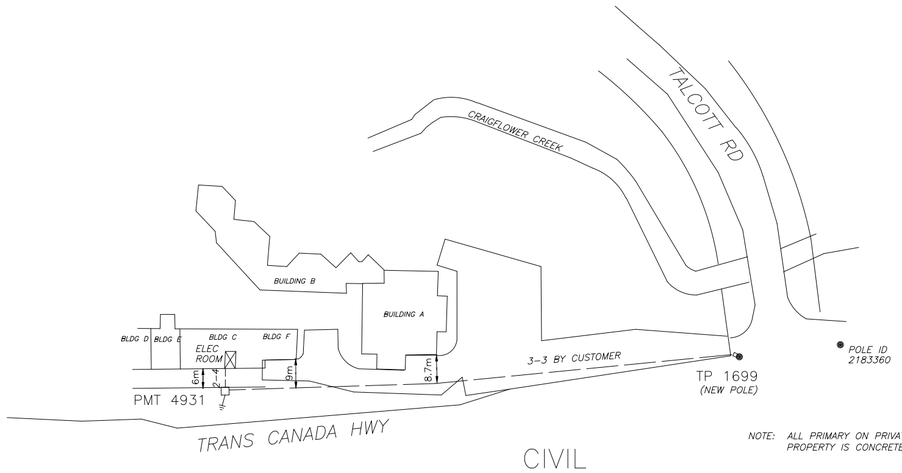

CIVIL
1:1000

NOTE: ALL PRIMARY ON PRIVATE PROPERTY IS CONCRETE ENCASED

ALL CIVIL WORK ON PUBLIC ROADWAY TO BE PERFORMED BY B.C. HYDRO CONTRACTOR

1m DUCT COVER

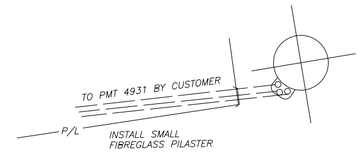

TERMINAL POLE DETAIL
N.T.S.

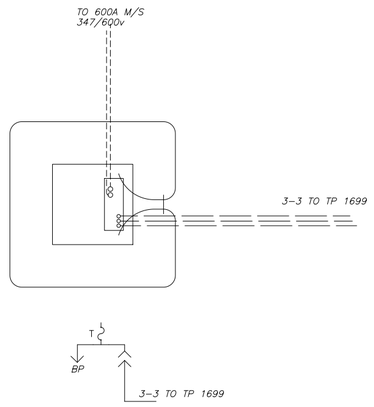

PMT 4931 PAD DETAIL
N.T.S.

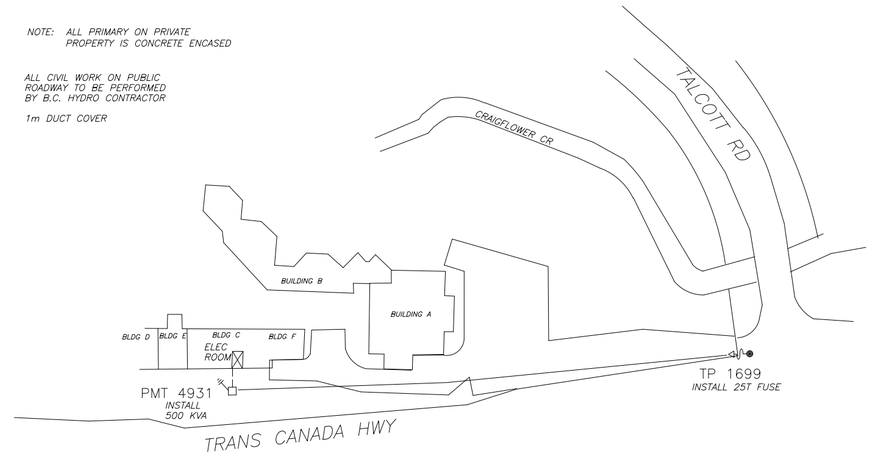

ELECTRICAL
1:1000

ELECTRICAL LEGEND:

2 X 4C 350 KCM AL SERVICE CABLE

3 X 1C #1AL 25kV CONCENTRIC NEUTRAL PRIMARY CABLE

NOTES:

1. Tag all primary and secondary feeds.
2. Install number decals on all primary installations and Terminal Pole cable cover.

No.	REMARKS	BY	APPR.	DATE
1	AS CONSTRUCTED	DB/ML		02-09-01

REVISIONS

REFERENCE DRAWINGS				DATE
		DES.	RK	01-04-19
CIRCUITS		DR.	MFL	01-04-20
GFIS MAPS	AON5C4	APPR.		
JOB		SCALE: AS SHOWN		
JOB 8370-748809		AutoCAD: C4728.DWG		

BC hydro

VANCOUVER ISLAND SOUTH
VICTORIA POWER DISTRICT
DISTRIBUTION U/G

PRIMARY DIP SERVICE TO
VIC.YOUTH CUSTODY CNT, TRANS CAN. HWY

SHT. 1 OF 1	REV. 1	DWG. No. R500-U07-C4728