



LEGEND

- CL w Chainage As Per BC MOTI's HRP Landmark 03-A-@-01649
- Approximate Shoulder and Road Edge

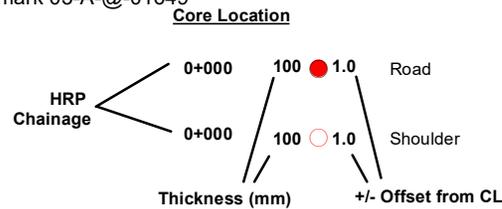

NOTES
Core locations and scale plotted to linear scale along the CL with offset exaggeration.

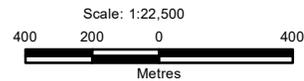

PROJECTION		DATUM	
NA		NA	
FILE NO.			
PAVE03225-28_Figure_1-4_Henry_Rd.mxd			
 BRITISH COLUMBIA Ministry of Transportation & Infrastructure		 TETRA TECH	

HENRY ROAD

**Pavement Thickness Investigation
From Nordic Road (0+000) to
E End of Maintained (0+663)**

OFFICE TL-VANC	DWN YL	CKD MB	APVD VS	REV 0
DATE January 20, 2025		PROJECT NO. PAVE03225-28		

Figure 1-4