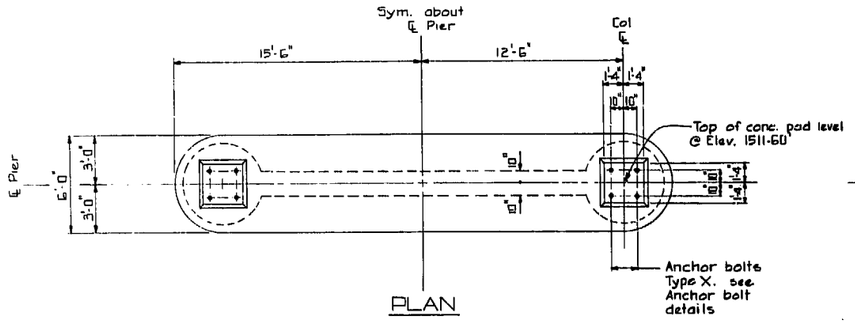

PLAN

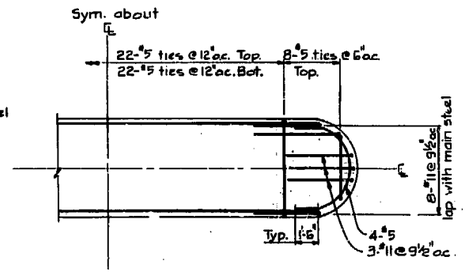

CAP REINF.

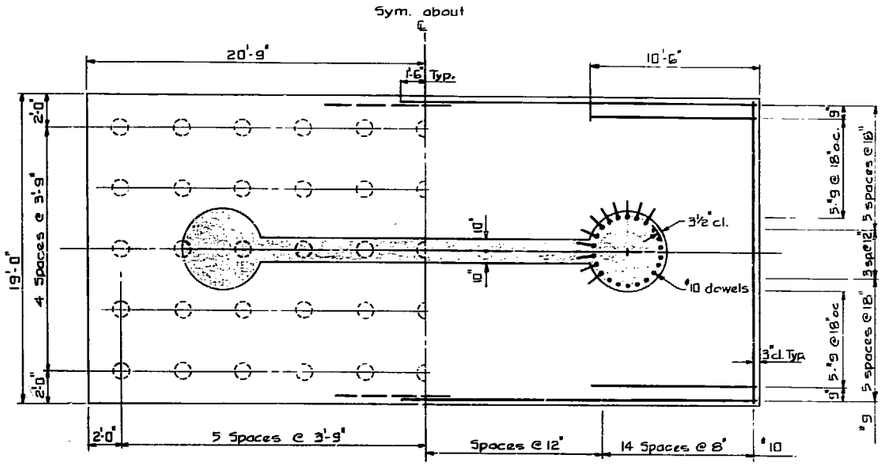

PILE LAYOUT

FTG. REINF.

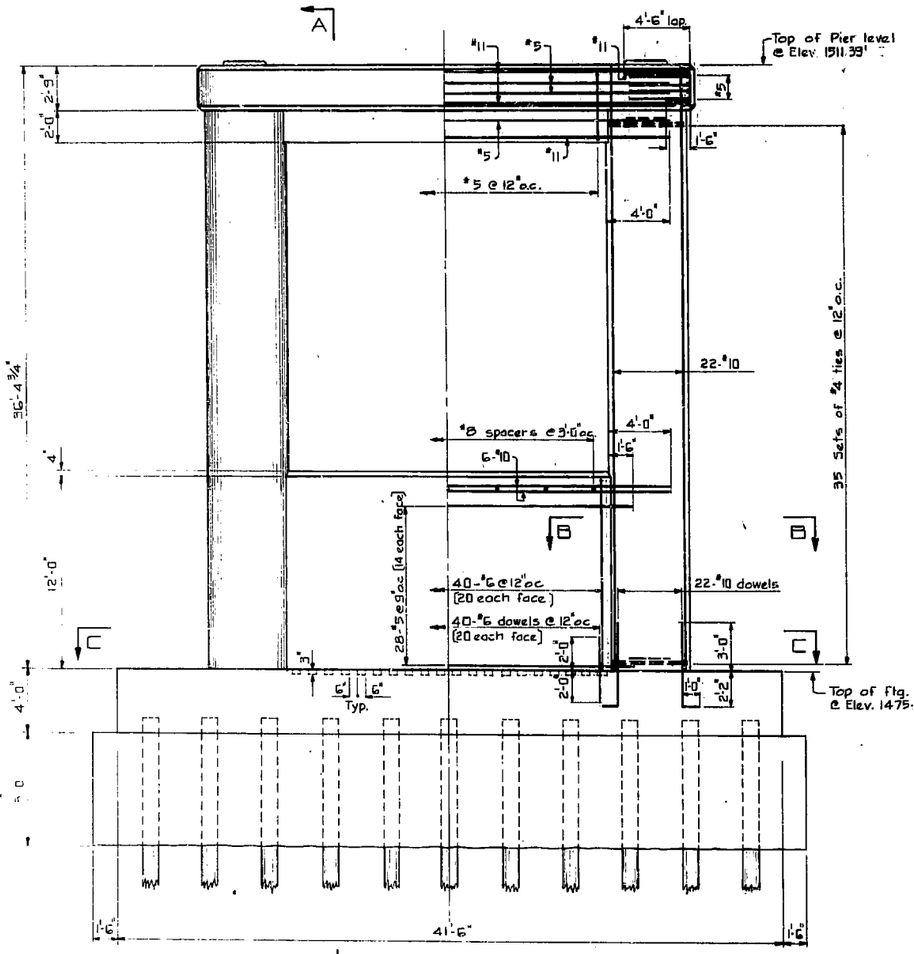

ELEVATION

PIERS #1 & #2

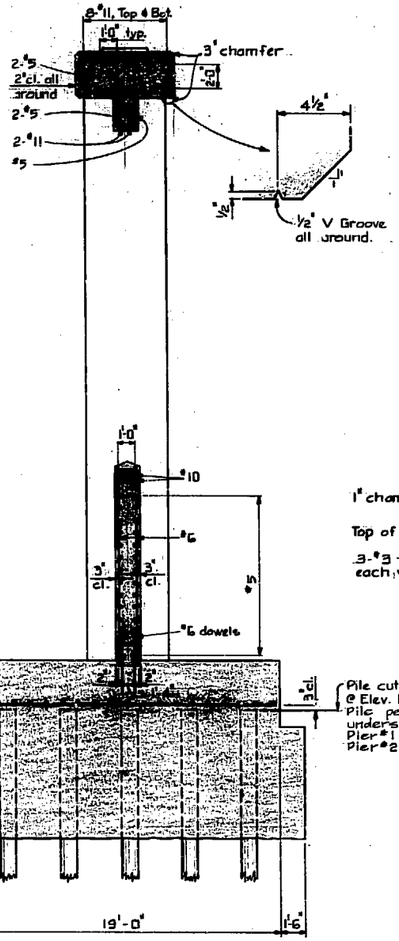

A-A

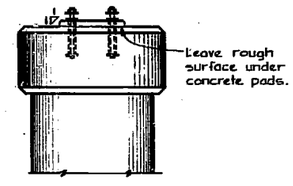

END ELEVATION

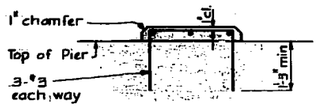

PAD REINF.

C-C

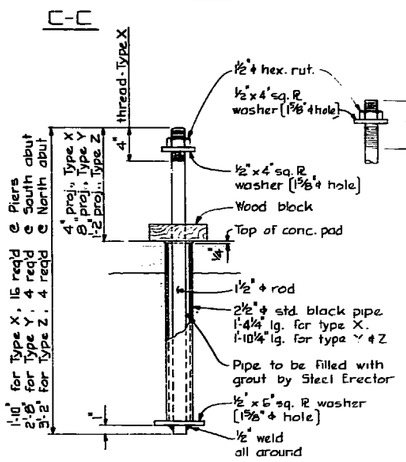

Not to be painted

B-B

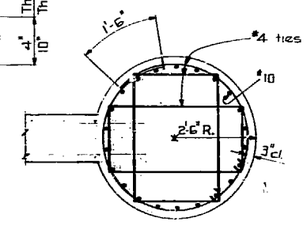

NOTE

Care to be taken in setting bolts to ensure pipes are properly centered thereon. Open ends of pipes to be sealed with block as shown to exclude water until erection of steel work. Use Fibregum or equal to secure watertightness.

ANCHOR BOLT DETAILS

NOTES

For general notes see Dwg. 599-22

NOTE

Depth of seal to be determined by contractor & approved by Engineer to suit time of construction

NO.	DATE	REVISION
Δ	Sept 64	As Built

GOV'T. OF THE PROV. OF BRITISH COLUMBIA
DEP'T. OF HIGHWAYS

CASTLEGAR - NELSON HIGHWAY
SHORE ACRES BRIDGE
OVER
SLOCAN RIVER

PIERS

CHOUKALOS, WOODBURN, HOOLEY & McKENZIE LTD
CONSULTING ENGINEERS
1159 West Broadway, Vancouver 9, B.C.

Drawn: D.R.H	Date.	Scale: ¼", ⅜", ½" - 1'0"
Checked WB WLL	June 9, 1961	DWG. 599-24X

PROFESSIONAL ENGINEER PROVINCE OF BRITISH COLUMBIA W. G. McKENZIE

GENERAL ARRANGEMENT APPROVED
CHIEF ENGINEER, DEPT. OF HIGHWAYS

54738