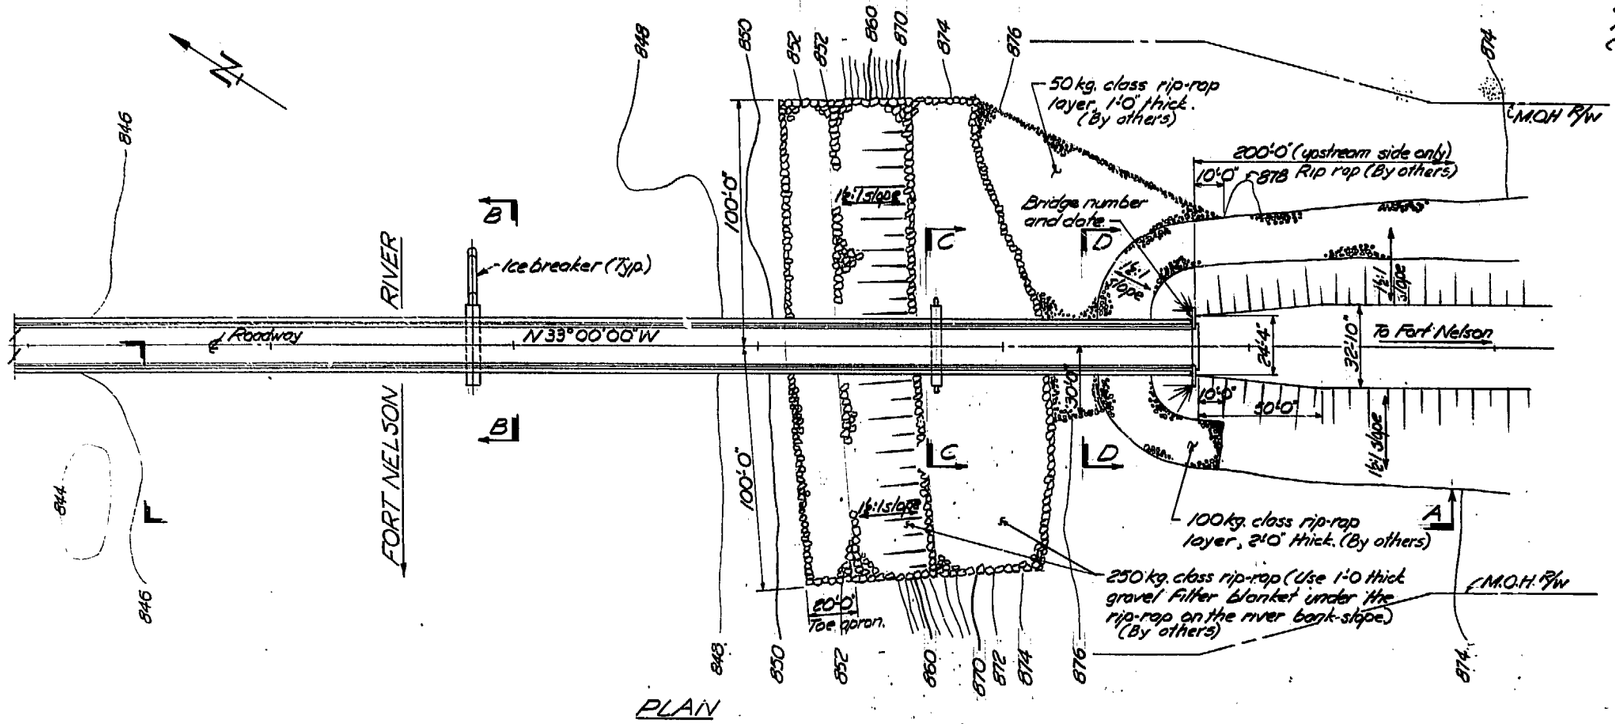

PLAN

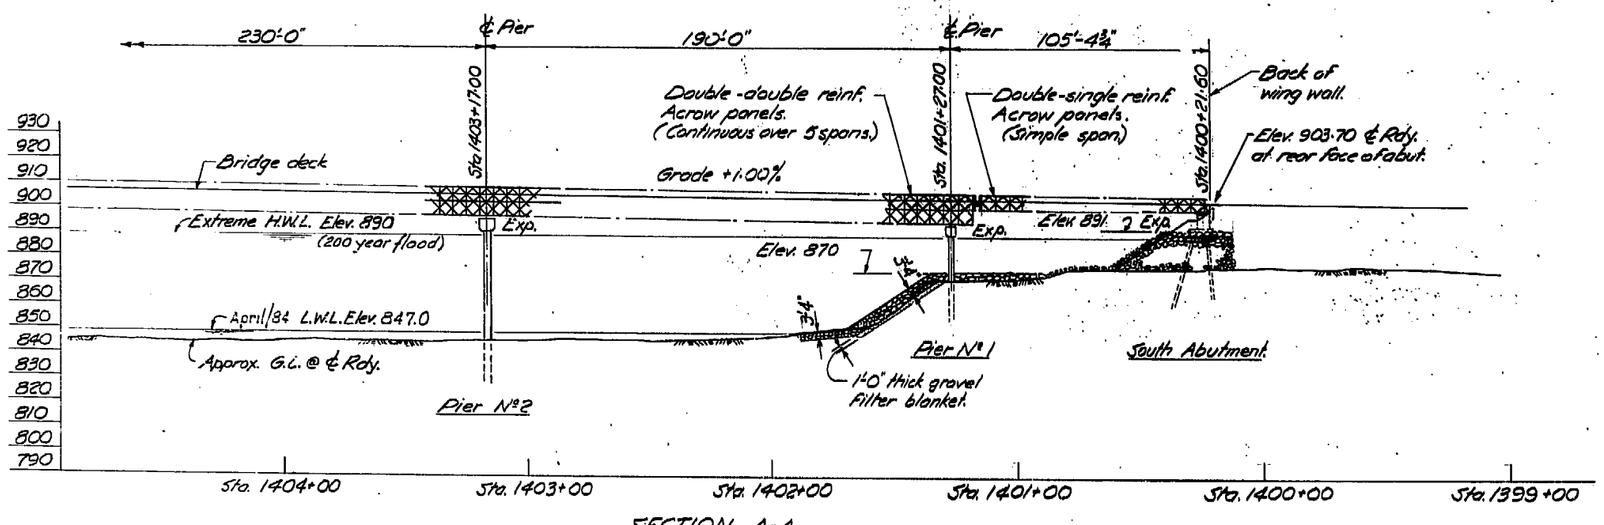

SECTION A-A

NOTE:
For continuation of PLAN and SECT. A-A see Dwg. No 2607-6

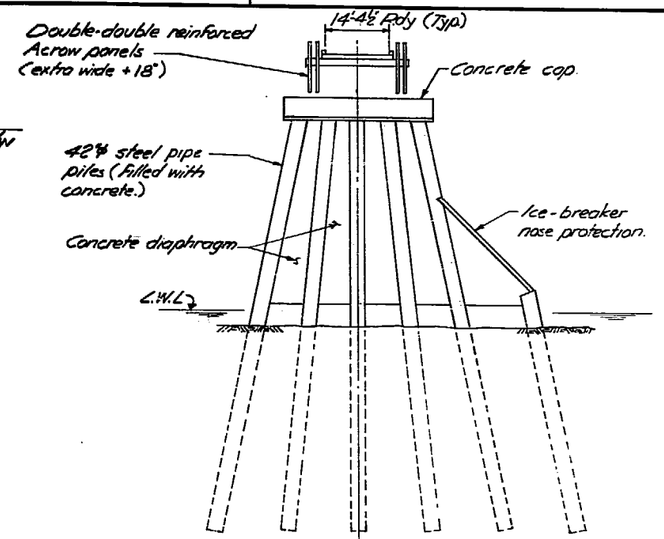

SECTION B-B (PIERS 2,3,4 & 5)
Scale: 1/16" = 1'-0"

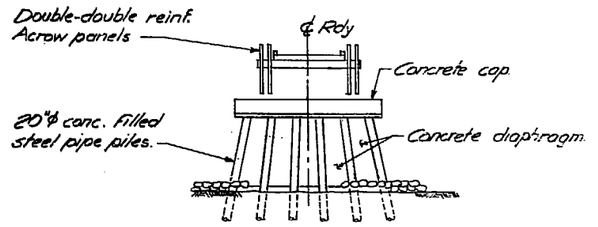

SECTION C-C (PIERS 1, 6 & 7)
Scale: 1/16" = 1'-0"

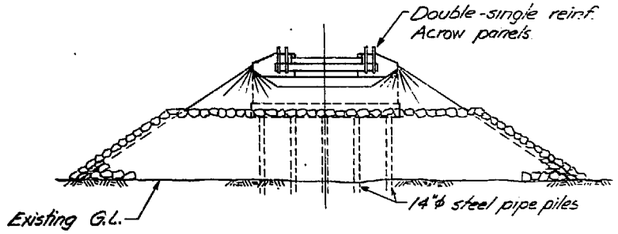

SECTION D-D
Scale: 1/16" = 1'-0"

NOTES:
1. Design Specifications - AASHTO 1977.
2. Design Loading - H525.

GOVERNMENT OF BRITISH COLUMBIA
MINISTRY OF TRANSPORTATION AND HIGHWAYS
BRIDGE ENGINEERING BRANCH

FORT ST. JOHN DISTRICT
FORT NELSON- FORT SIMPSON HIGHWAY
FORT NELSON RIVER BRIDGE
GENERAL ARRANGEMENT- SHEET 2

D			
C			
B			
A	As Built	G.D.W.	July/84
	REVISIONS		

PREPARED UNDER THE DIRECTION OF T. J. Vickers, SENIOR BRIDGE DESIGN ENGINEER	DATE 83/05/12	SCALE: 1"=30'-0" AND NOTED	DWG No 27391 4		
		DRAWN P.B	Apr/83	CHECKED	Apr/83
APPROVED FOR USE IN CONSTRUCTION, DIRECTOR OF BRIDGE ENGINEERING	DATE 83.05.12	EXAMINED AND ACCEPTED, EXECUTIVE DIRECTOR OF ENGINEERING	DATE 1983 05 13	DRAWING No. 2607-7	A

CANCEL PRINTS BEARING EARLIER LETTER