
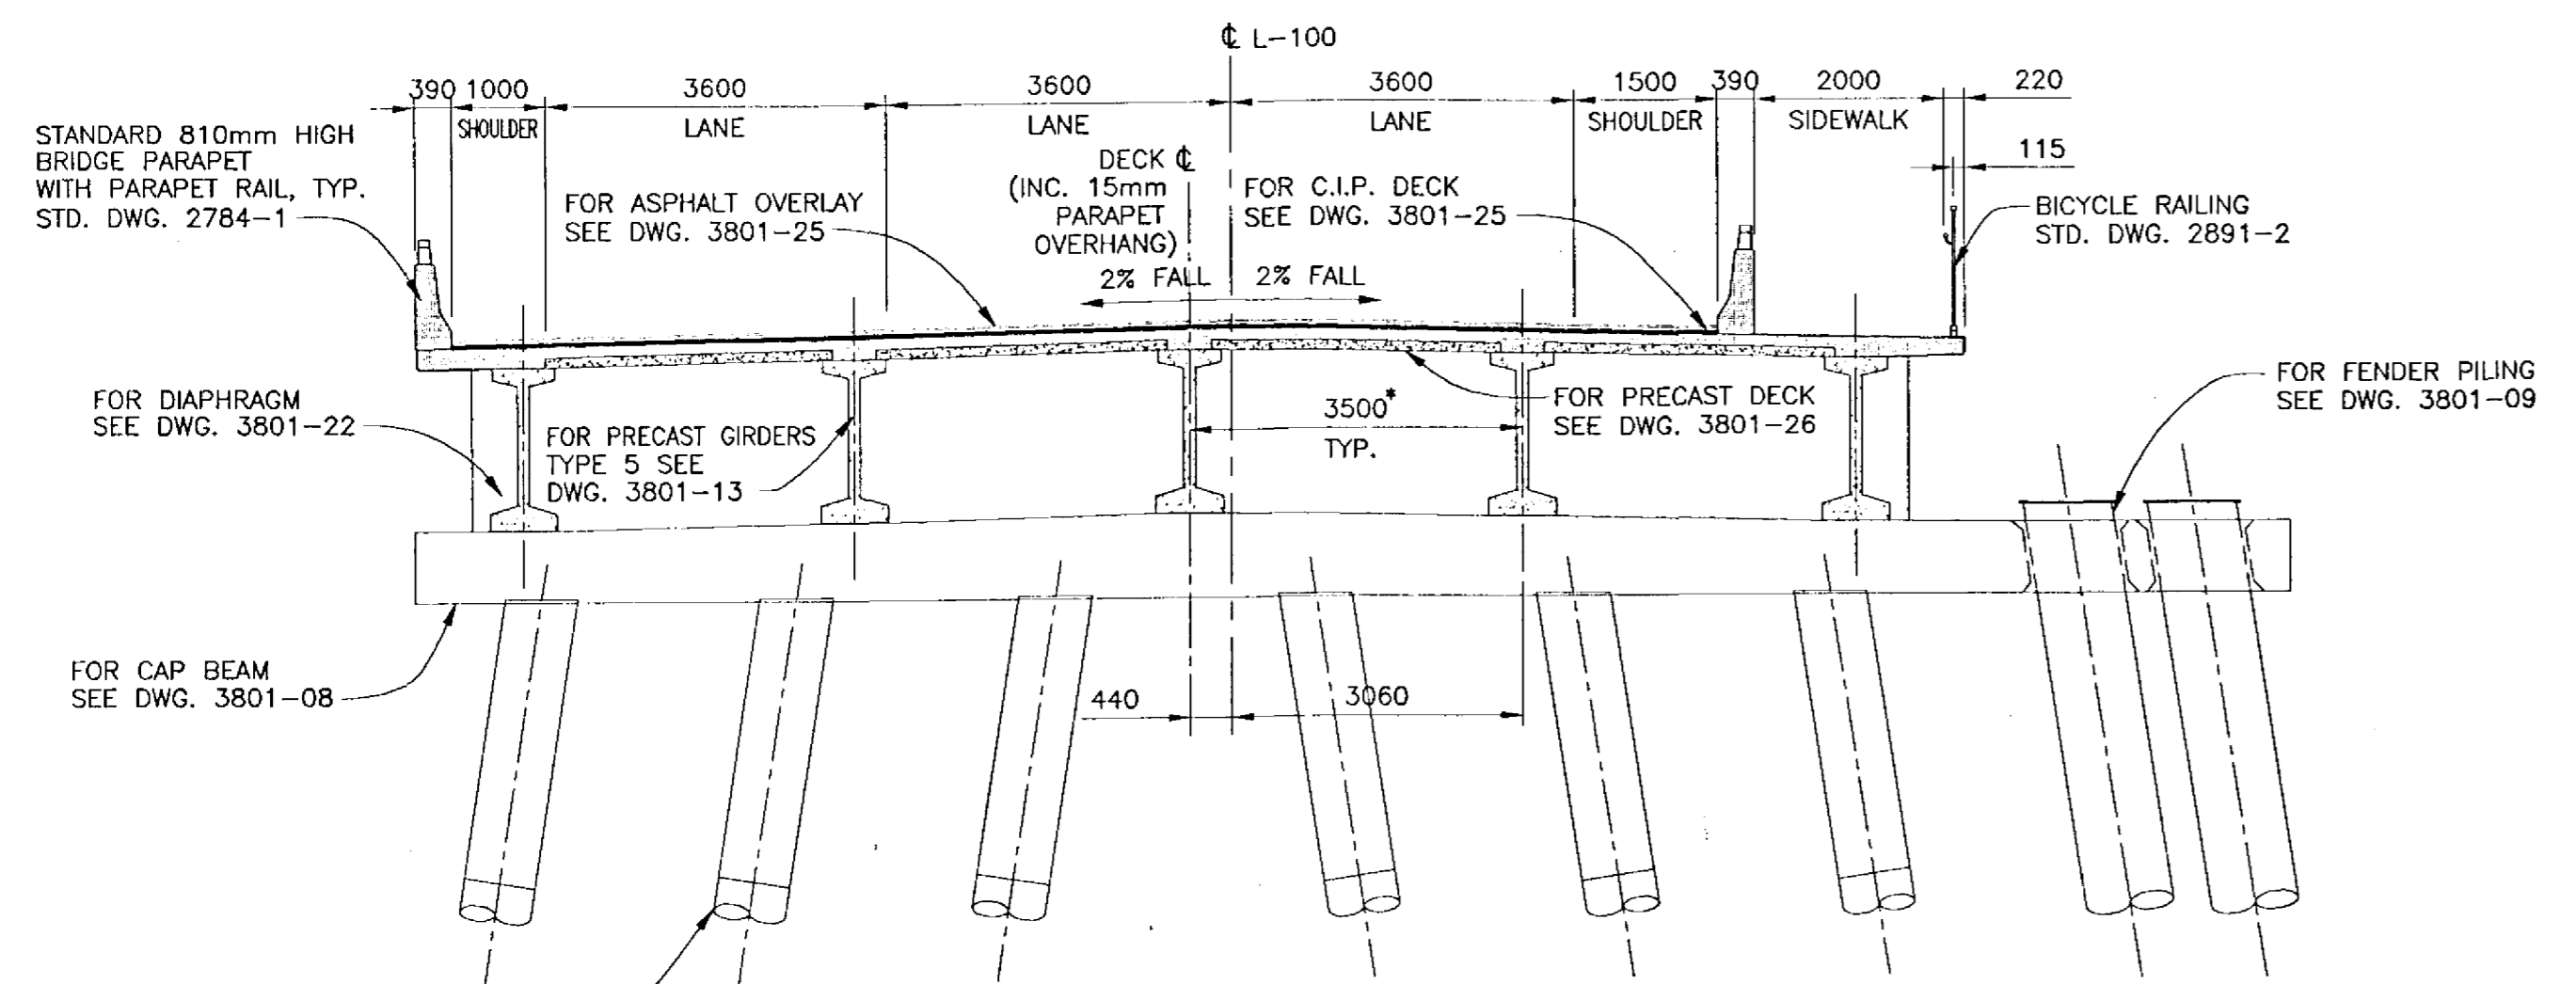


- DESIGN CRITERIA:**
- DESIGN SPECIFICATIONS:
    - CAN/SCA-S6-88
    - ONTARIO HIGHWAY BRIDGE DESIGN CODE
    - AASHTO SEISMIC DESIGN GUIDELINES
  - DESIGN LOADS:
    - LIVE LOAD - CS-600
    - DEAD LOAD - INCLUDES 90mm THICK WEARING SURFACE ALLOWANCE
  - SEISMIC DESIGN:
    - RETURN PERIOD: 10% EXCEEDENCE PROBABILITY IN 50 YEARS (1 IN 475 YEARS)
    - RESPONSE SPECTRUM  $C_s=1.2AS$
    - $A=0.21g$
    - $S=1.5$
    - $T=$  NATURAL PERIOD OF STRUCTURE
  - DESIGN LIFE 100 YEARS.
  - DESIGN TEMPERATURE RANGE: 22.3°C, -2.5°C
  - WIND LOAD 1 IN 100 YR. RETURN: S6, WITH  $q_{100} = 0.67kPa$
  - SNOW LOAD: N.B.C. WITH  $S_s = 1.4kPa$  &  $S_r = 0.2 kPa$

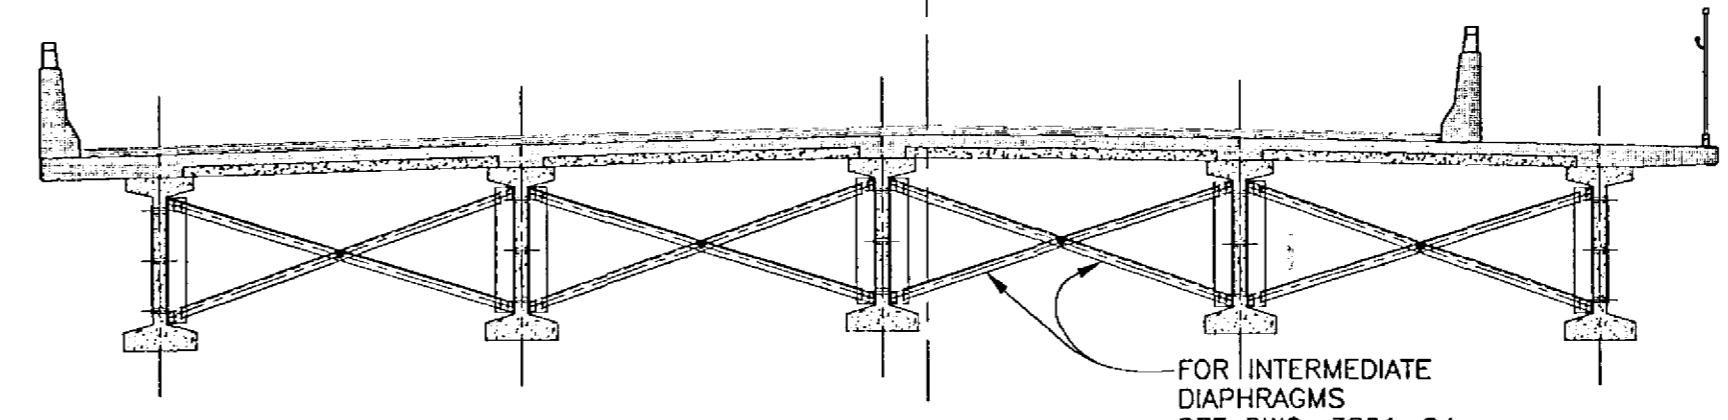

Rev	Date	Description	Init	SCALE	DESIGNED	DATE	CHECKED	DATE	DRAWN	DATE
0	00/08/04	ISSUED FOR CONSTRUCTION	AGM	AS SHOWN	A.G.M.	99/11/29	G.J.M.	02/07/07	D. PANG	99/11/29
1	01/09/21	RECORD PRINT	AGM							

Rev	Date	Description	Init

390458

**BCTFA**  
BC Transportation Financing Authority

**VVR**  
Vancouver International Airport Authority

LOWER MAINLAND DISTRICT  
AIRPORT CONNECTOR PROJECT  
MIDDLE ARM BRIDGE NO. 3801  
GENERAL ARRANGEMENT

OCT 04 2001

Design Consultant: **Sandwell**

PREPARED UNDER THE DIRECTION OF: ANTHONY G. MARTIN, CONSULTANT

DATE: AUGUST 4 2000

PROJECT No. 11611

REGION: -

DRAWING No. 3801-02 1

FILE No. -

ISSUE RECORD

REVISIONS

SANDWELL CAD FILE No. 142586\LOCAL\MARINE\23586R02.dwg