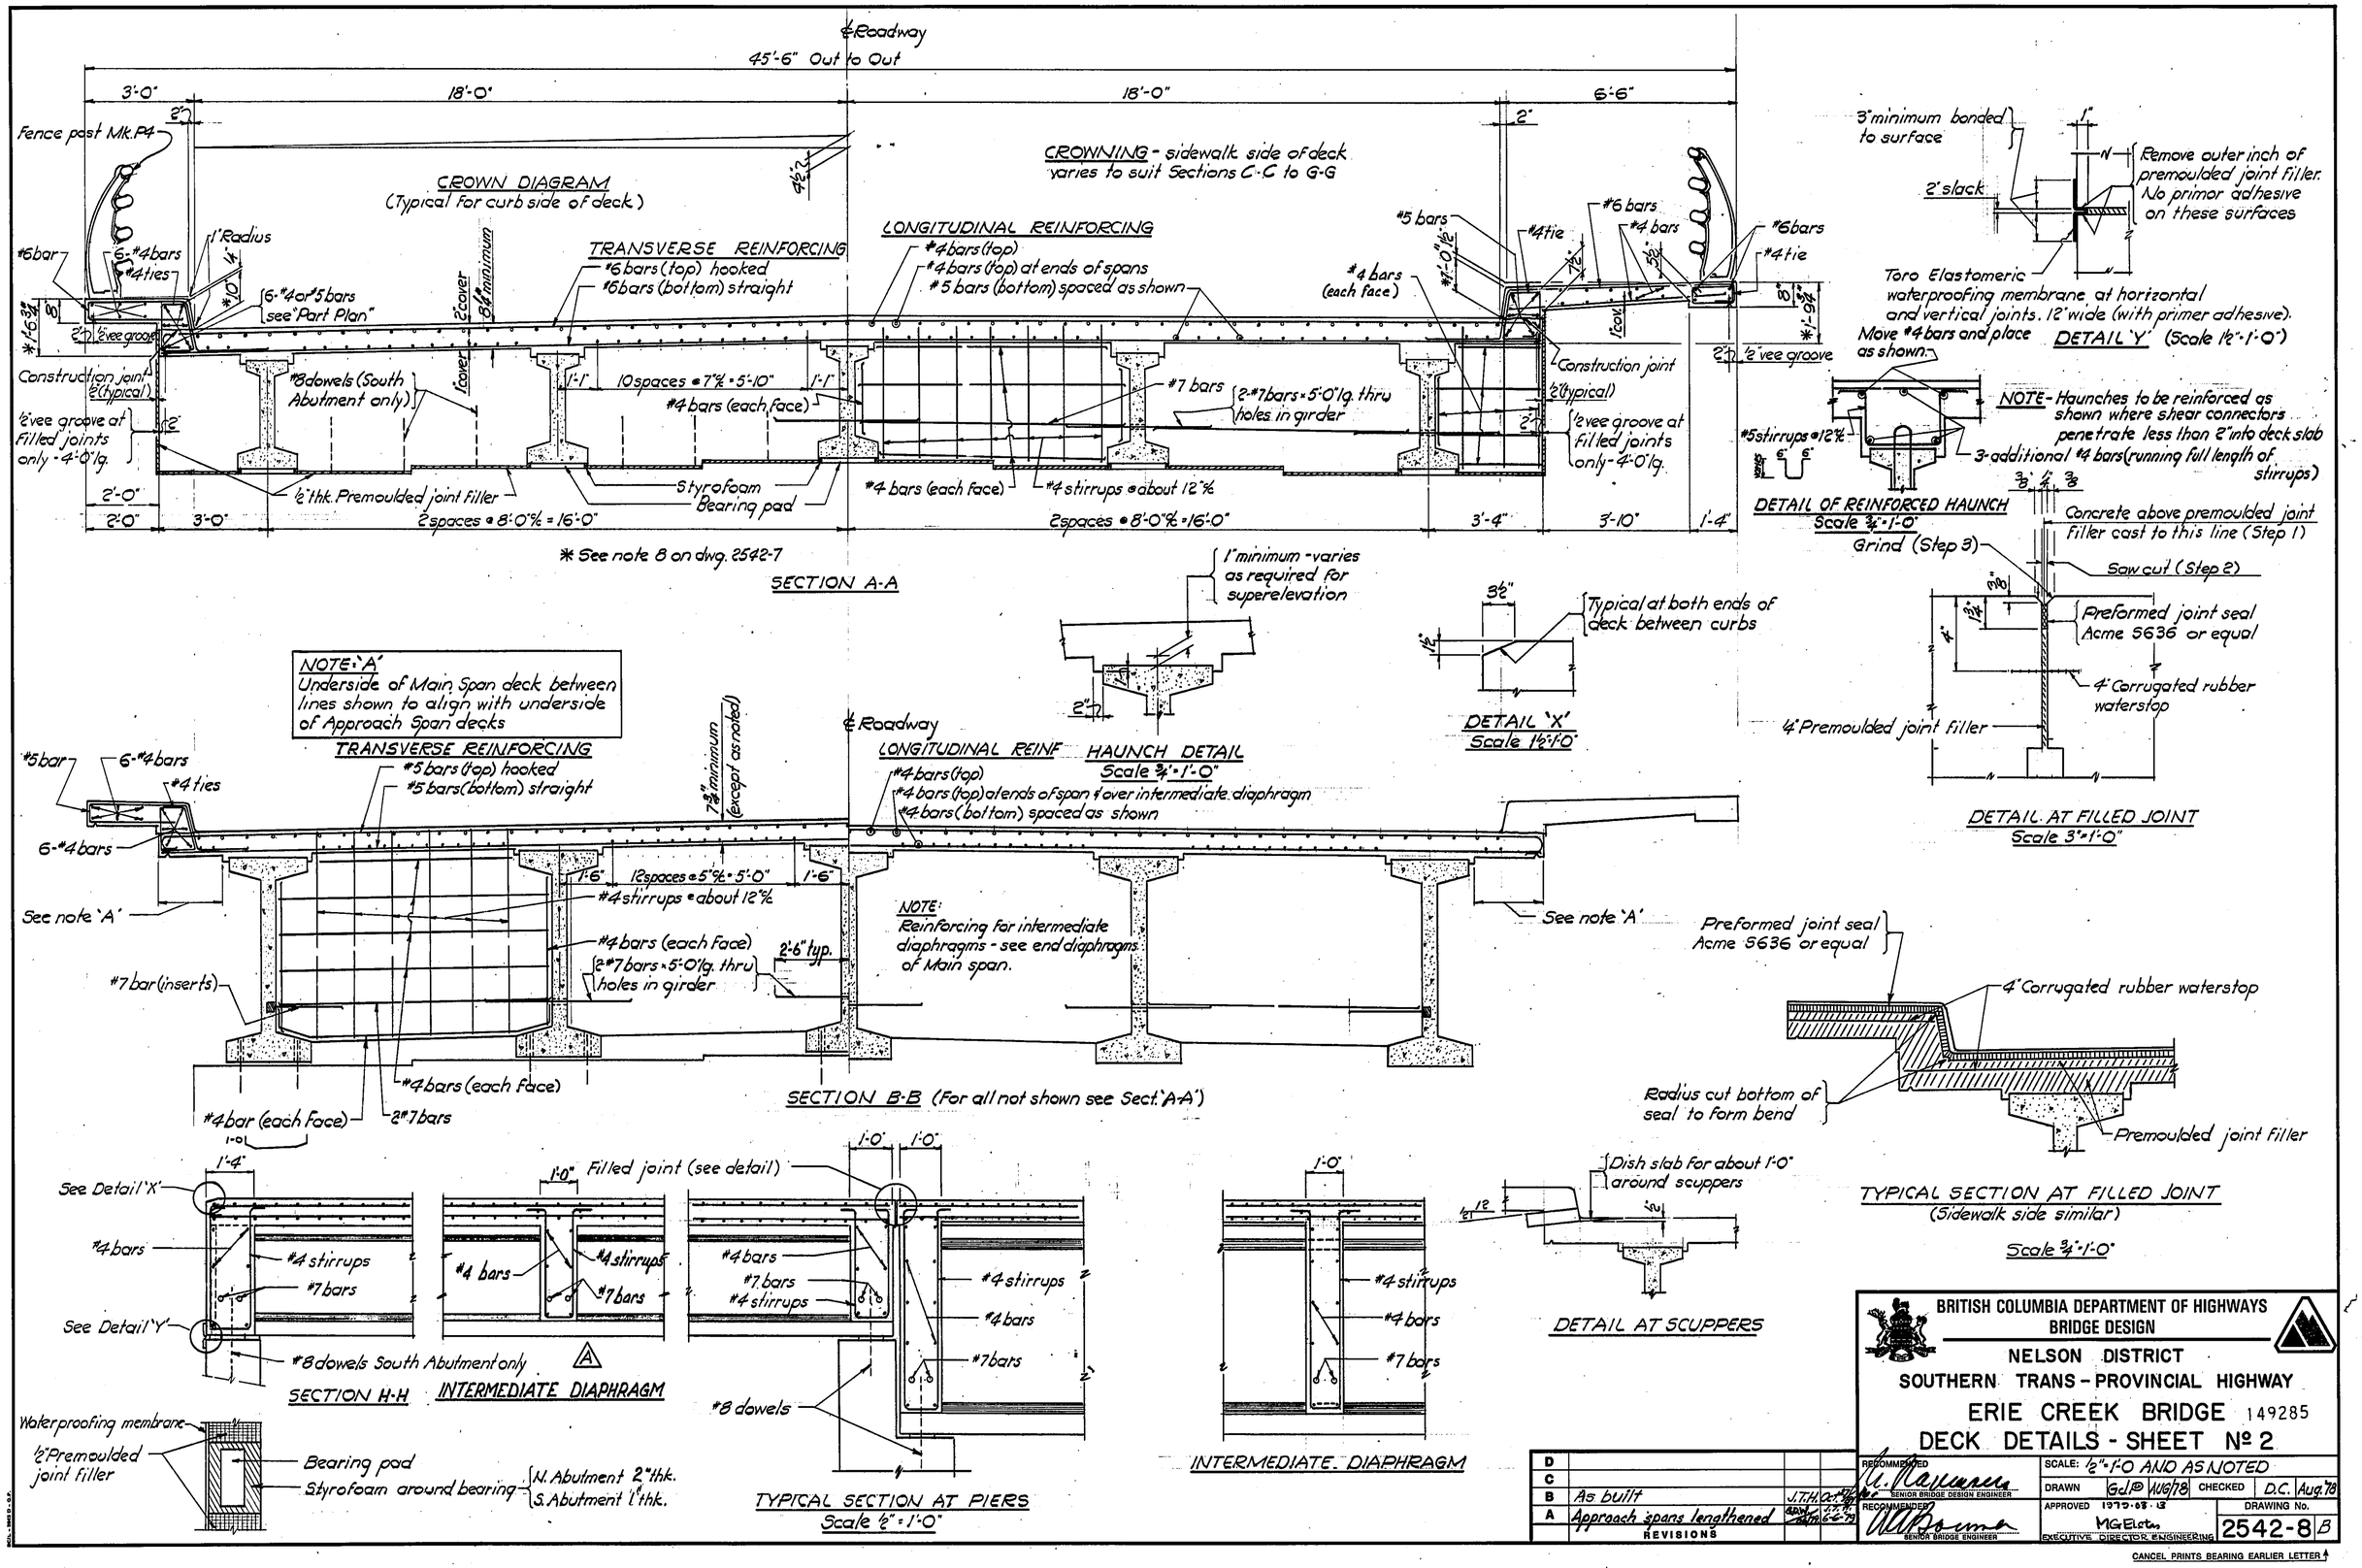

BRITISH COLUMBIA DEPARTMENT OF HIGHWAYS
BRIDGE DESIGN

NELSON DISTRICT
SOUTHERN TRANS-PROVINCIAL HIGHWAY

ERIE CREEK BRIDGE 149285

DECK DETAILS - SHEET Nº 2

D			
C			
B	As built	J.T.H.	Oct. 1979
A	Approach spans lengthened	J.T.H.	6-6-79
	REVISIONS		

RECOMMENDED: SENIOR BRIDGE DESIGN ENGINEER
RECOMMENDED: SENIOR BRIDGE ENGINEER

SCALE: ½" = 1'-0 AND AS NOTED
DRAWN: GdP AUG/78 CHECKED: D.C. Aug. '78
APPROVED: 1979-08-13 M G Elston EXECUTIVE DIRECTOR ENGINEERING
DRAWING No. 2542-8 B

CANCEL PRINTS BEARING EARLIER LETTER