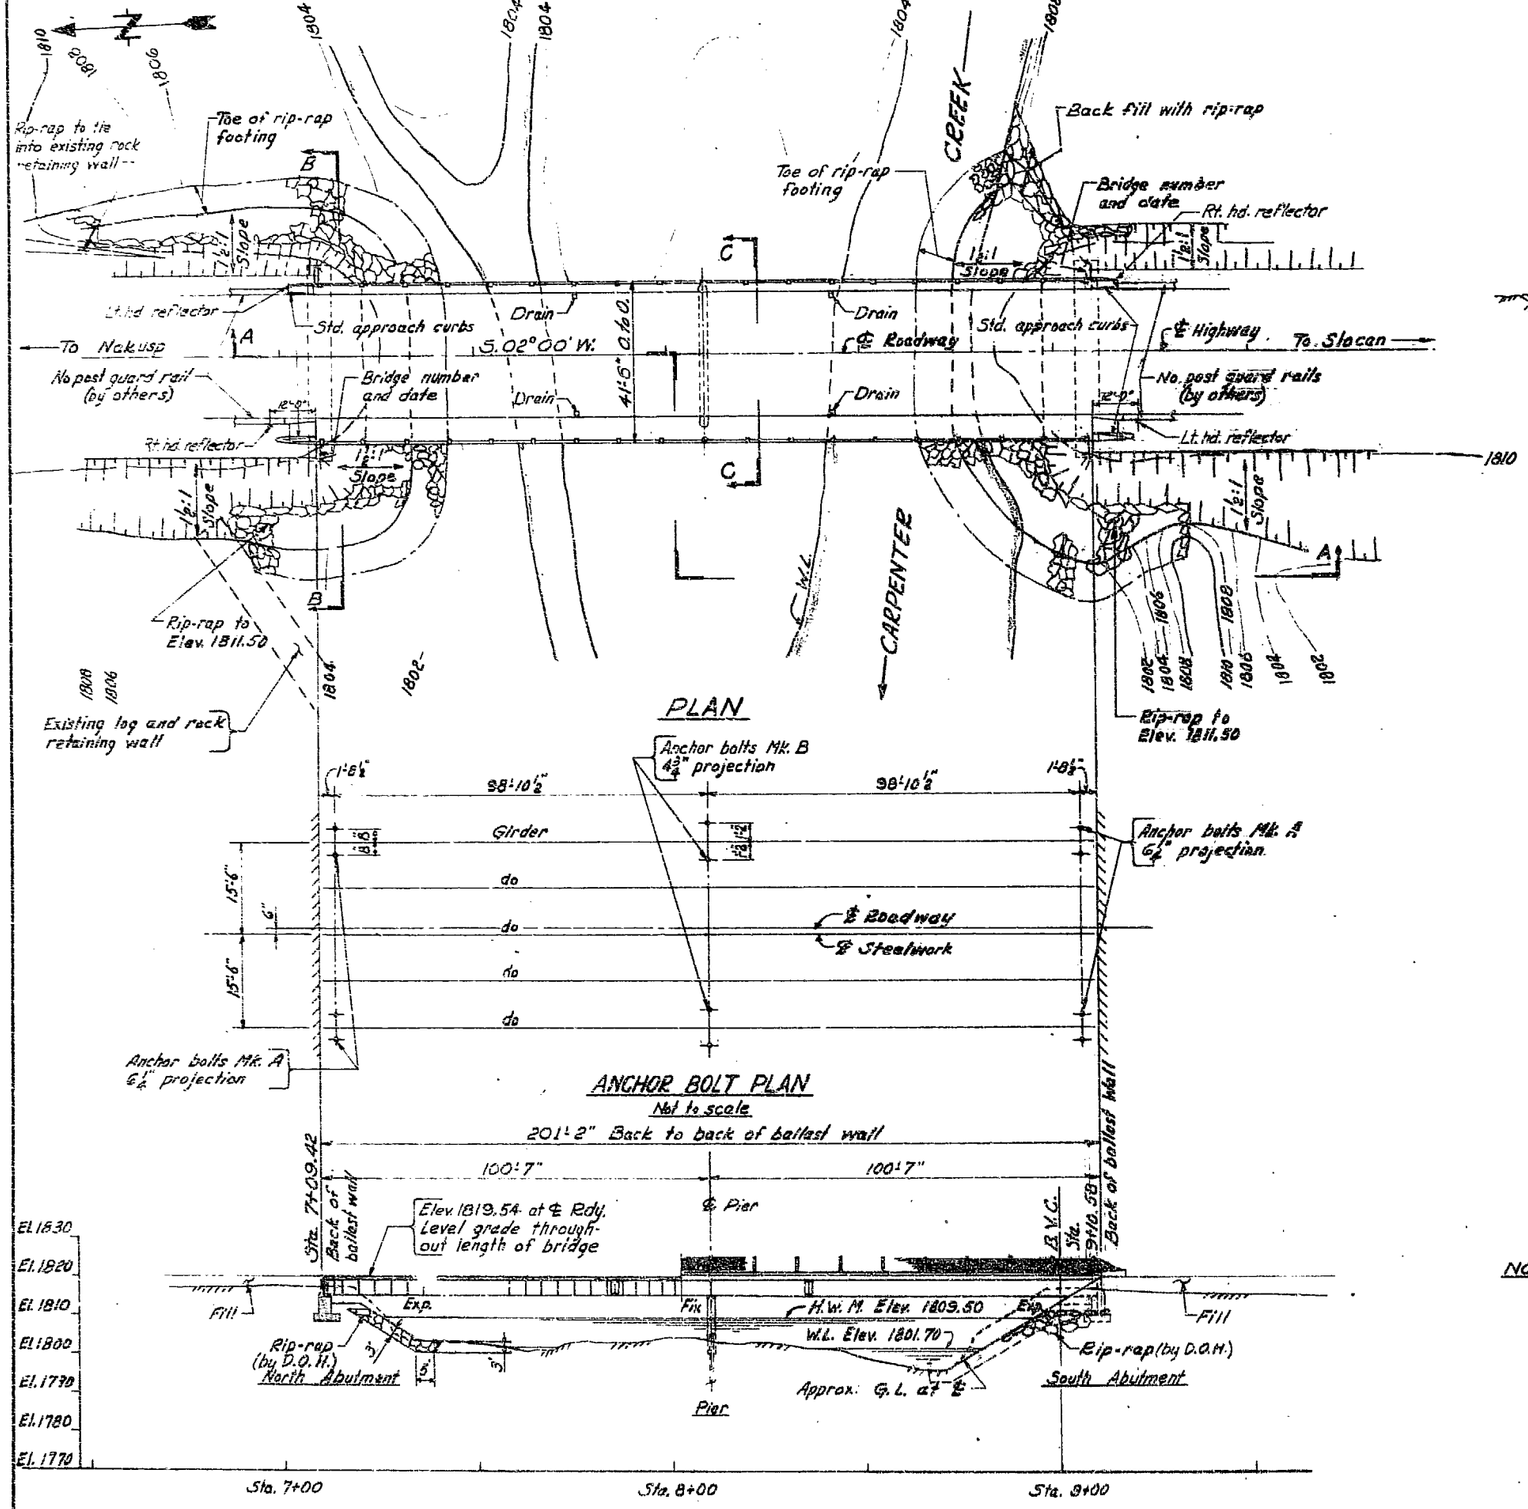

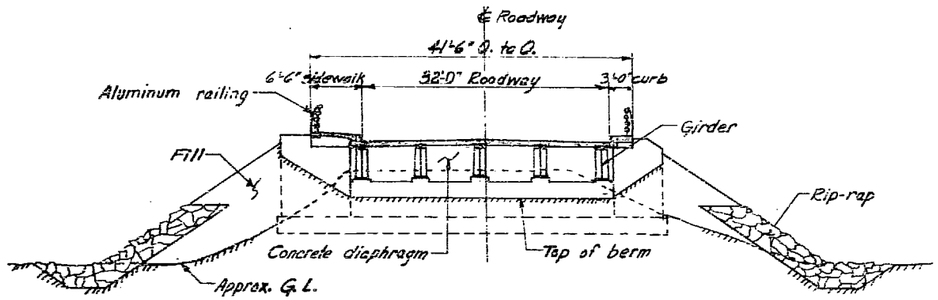

SECTION B-B
Scale: 1"=10'-0"

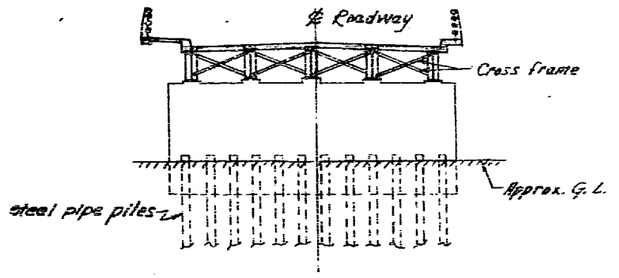

SECTION C-C
Scale: 1"=10'-0"

NOTES:-
1.-Specifications : A.A.S.H.O. (1969)
2.-Live Load : H25-S20

109970

D			
C			
B	As Built - no revisions	K.J.M.	14-1-75
A	Finished grade lowered 6"	P.B.	

REVISIONS

BRITISH COLUMBIA DEPARTMENT OF HIGHWAYS
BRIDGE ENGINEERING BRANCH

NEW DENVER DISTRICT
VERNON SLOCAN HIGHWAY
NEW DENVER BRIDGE
GENERAL ARRANGEMENT

APPROVED ... BRIDGE ENGINEER
APPROVED ... CHIEF ENGINEER

SCALE: 1"=20'-0" AND AS NOTED
DRAWN N.E.D. (1975)
CHECKED B.V. M.W.
DRAWING No. 789-9.8

CANCEL PRINTS BEARING EARLIER LETTER