


Cariboo Highway No. 97: Williams Lake I.R. To Lexington Road / Four Laning Project

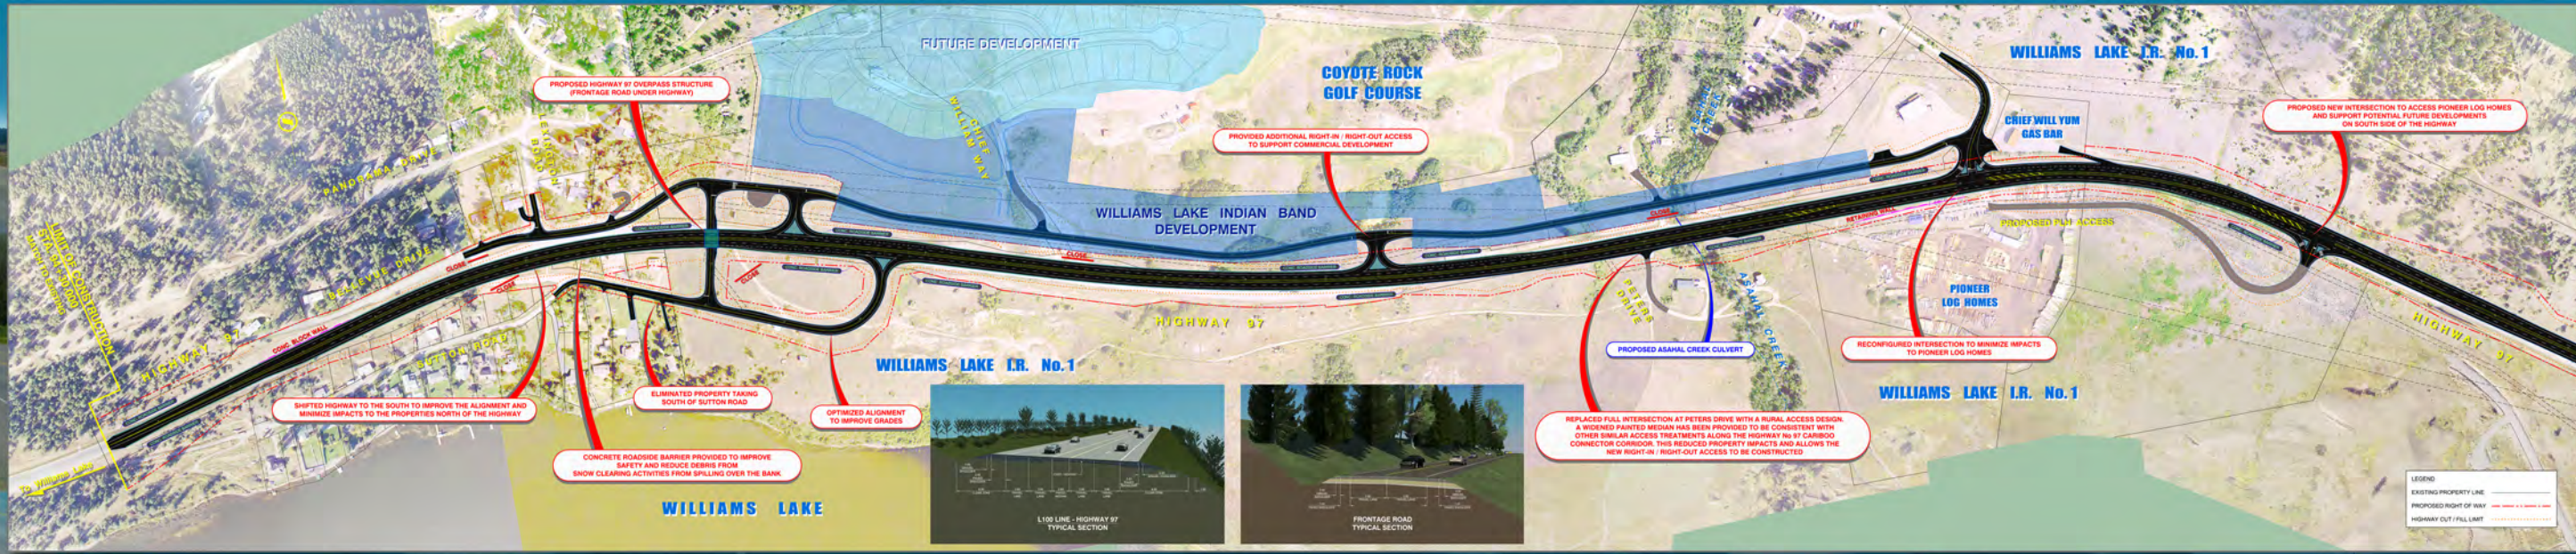

Cariboo Highway No. 97: Williams Lake I.R. To Lexington Road / Four Laning Project

