



SNC-LAVALIN
Morrow Environmental

Client :
Imperial Oil Limited

Borehole No. : 01-H13


Location :
3201 Douglas Street, Saanich, BC

(Page 1 of 1)

Drilling Contractor: McRae's Environmental
Drilling Method : Vacuum Truck
Borehole Dia. (m) : 0.30
Pipe/Slotted Pipe Dia. (m): 0.05, 0.05

Date Monitored : 2004 11 16
Ground Surf Elev. (m) : 8.55
Top of Casing Elev. (m) : 8.525

Project Number : 130921
Borehole Logged By : SPJ
Date Drilled : 2001 01 23
Log Typed By : SPJ

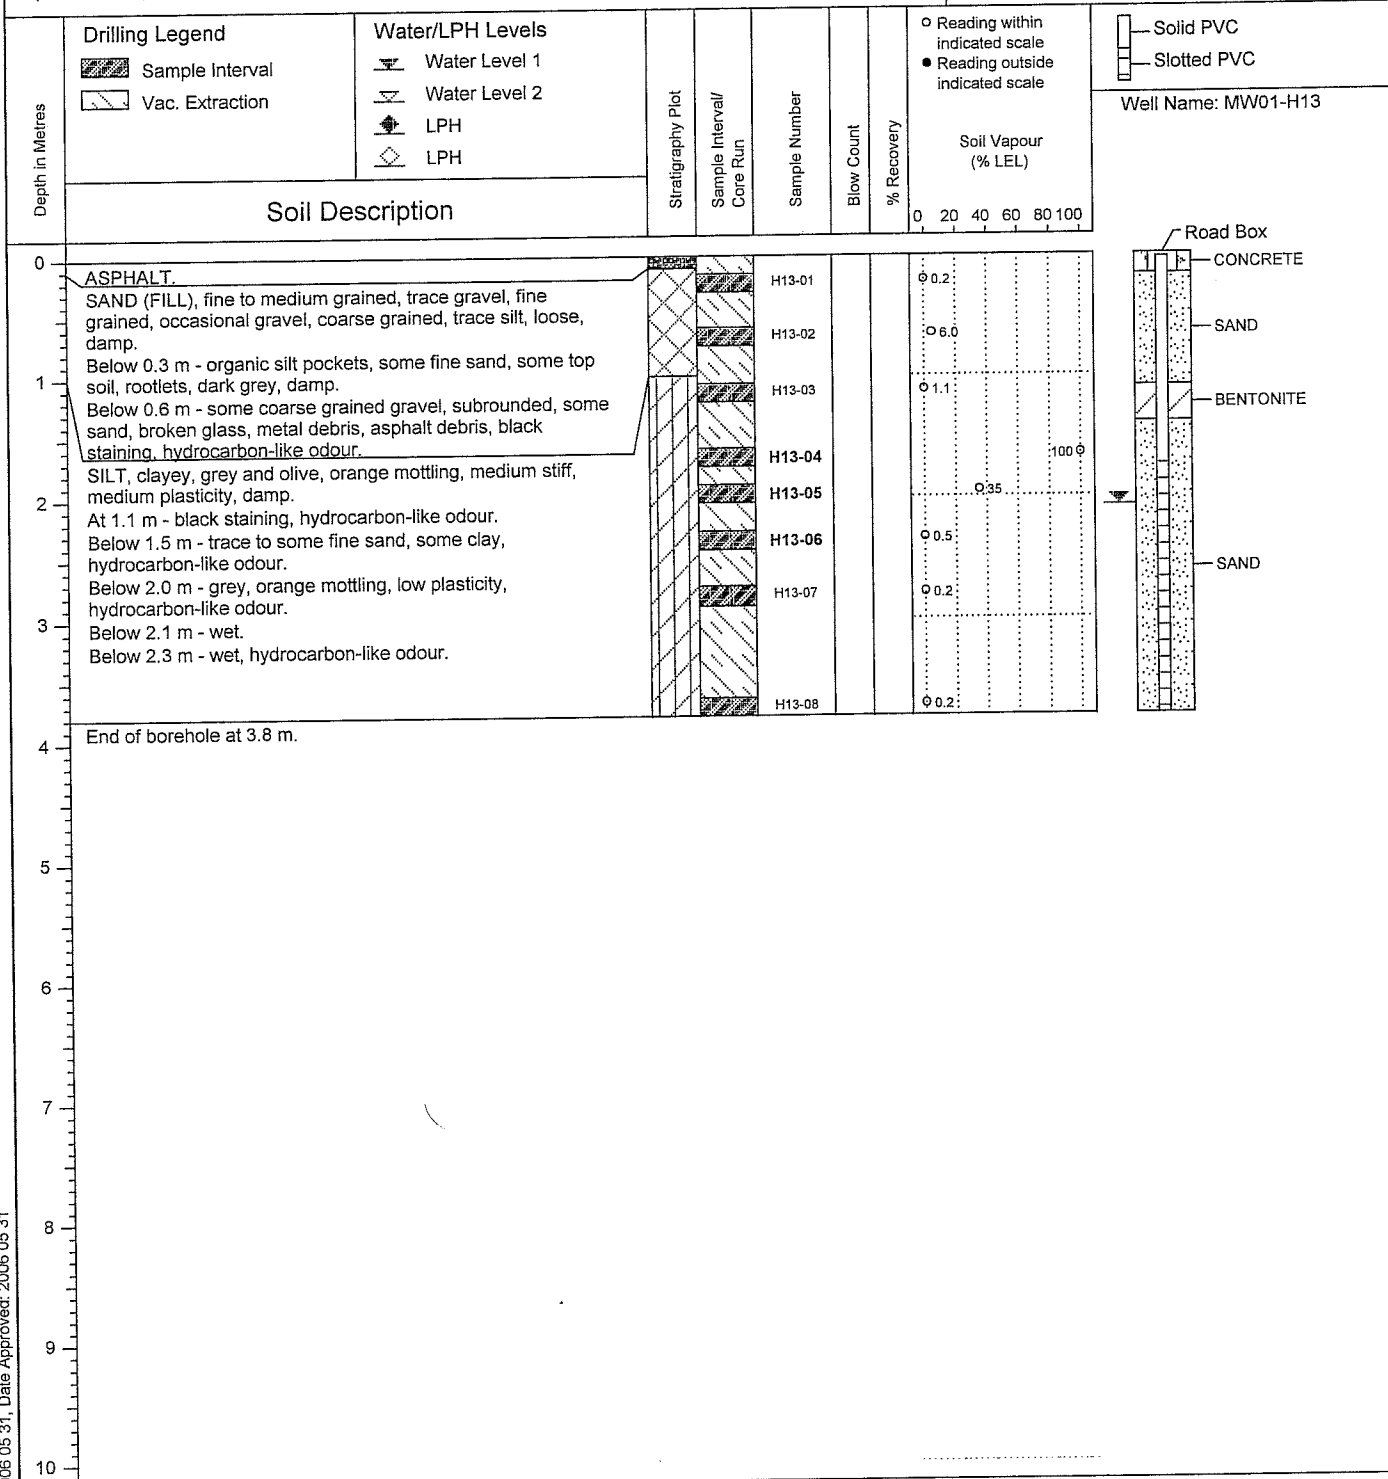

Print Date: 2006 05 31, Date Approved: 2006 05 31

Notes:
Bolded sample denotes sample analyzed.



SNC-LAVALIN
Morrow Environmental


Slug Test Analysis Report

Project: Imperial Oil - Swiss Chalet Management A

Number: V6-245/130921

Client: Imperial Oil Limited

rising head #1 [Bouwer & Rice]

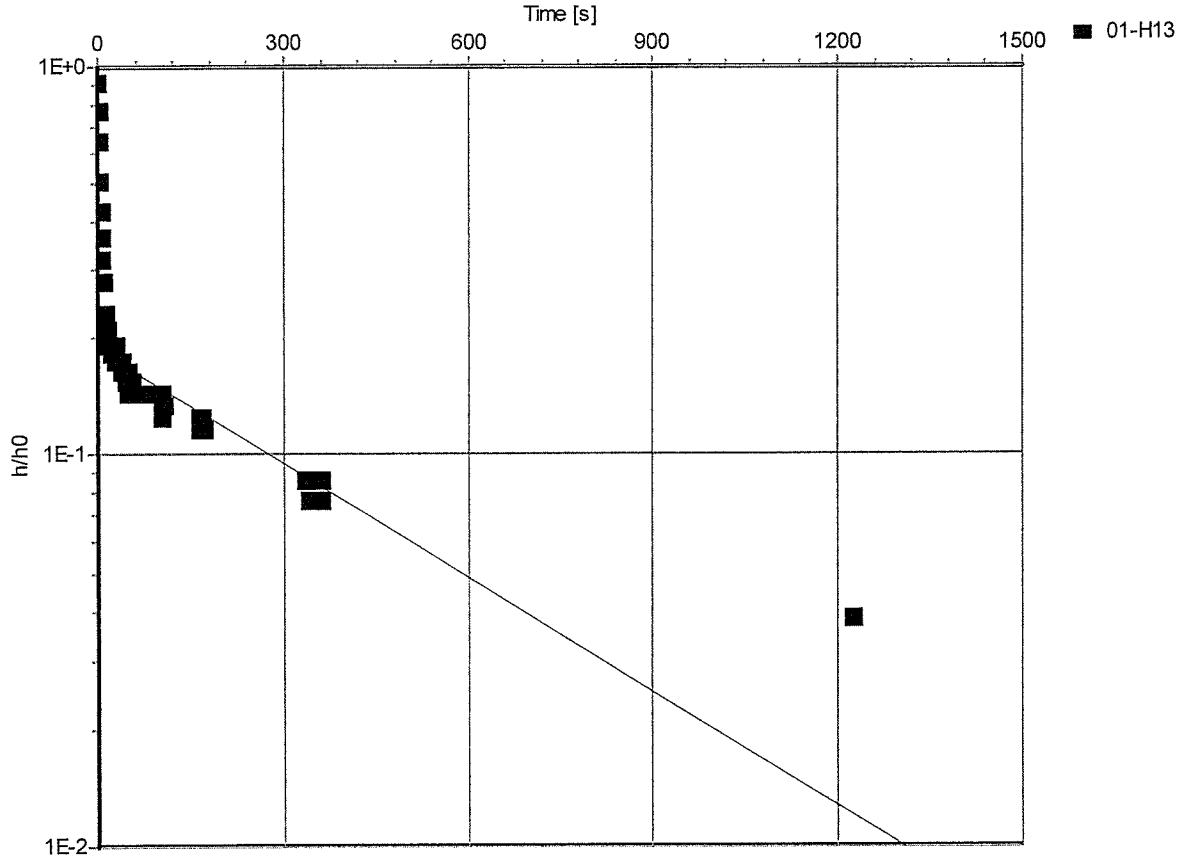

Slug Test: rising head #1

Analysis Method: Bouwer & Rice

Analysis Results:

Conductivity: 4.34E-6 [m/s]

Test parameters:

Test Well:	01-H13	Aquifer Thickness:	5 [m]
Casing radius:	0.025 [m]	Gravel Pack Porosity (%):	25
Screen length:	2.5 [m]		
Boring radius:	0.15 [m]		
r(eff):	0.078 [m]		

Comments:

Evaluated by: pac

Evaluation Date: 6/15/2006