

# LOG OF BORING MW08-1


(Page 1 of 1)

Client: Arten Investments Ltd.  
 Site Address: 8140 Scott Road  
 Surrey, BC

Installation Date : August 21, 2008  
 Contractor : Mud Bay Drilling Company Ltd.  
 Drill Type : Odex  
 Logged By : Cory Cavazzi  
 Well Installed : No (well abandoned)

Project 229-22.02

Depth in Meters	USCS	GRAPHIC	Water Level	List of Acronyms TOC: Top of Well Casing DTW: Depth to Water from TOC	SAMPLES	SAMPLE NAME	Vapours	REMARKS
			▼ ▽					
0	AR							
1						MW08-1		
2						MW08-2	0 ppm	
3								
4								
5								
6								
7	SP							
8								
9								
10								
11								
12								
13								
14	SP							
15								
16								
17								
18								
19								
20								
21								
22								
23	SM							
24								
25								
26								
27								
28								
29								
30								
31								
32								
33								
34								
35								
36								
37								
38								
39								
40								
41								
42								
43	SW							
44								
45								
46								
47								
48								
49								
50								
51								
52								
53								
54								
55								
56								
57								
58								
59								
60								

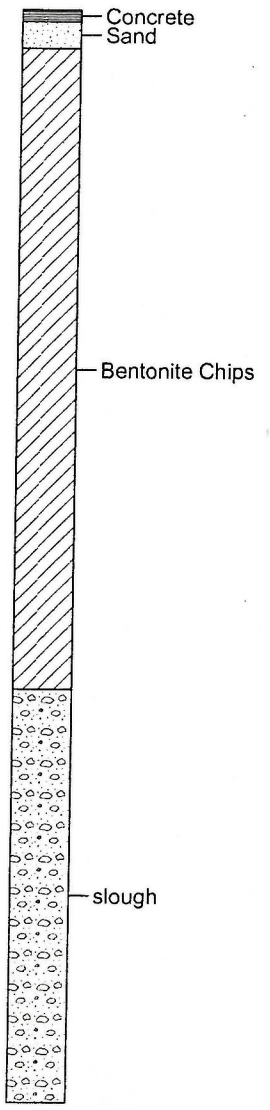

10-31-2008 T:\0200-3991229 Arten\22.02\BH-Logs\MW08-1.bor

End of hole at 56.4m  
 (borehole abandoned)