



SNC-LAVALIN
Morrow Environmental

Client :
Shell Canada Products

Borehole No. : BH07-6


Location :
7226 West Saanich Road, Brentwood Bay, BC

(Page 1 of 1)

Drilling Contractor: Drillwell Enterprises Ltd.
Drilling Method : Solid Stem Auger
Borehole Dia. (m) : 0.15
Pipe/Slotted Pipe Dia. (m): 0.05, 0.05

Date Monitored : 2007 11 20
Ground Surf Elev. (m) : 66.13
Top of Casing Elev. (m) : 66.06

Project Number : 130504
Borehole Logged By : LMH
Date Drilled : 2007 10 25
Log Typed By : MAL

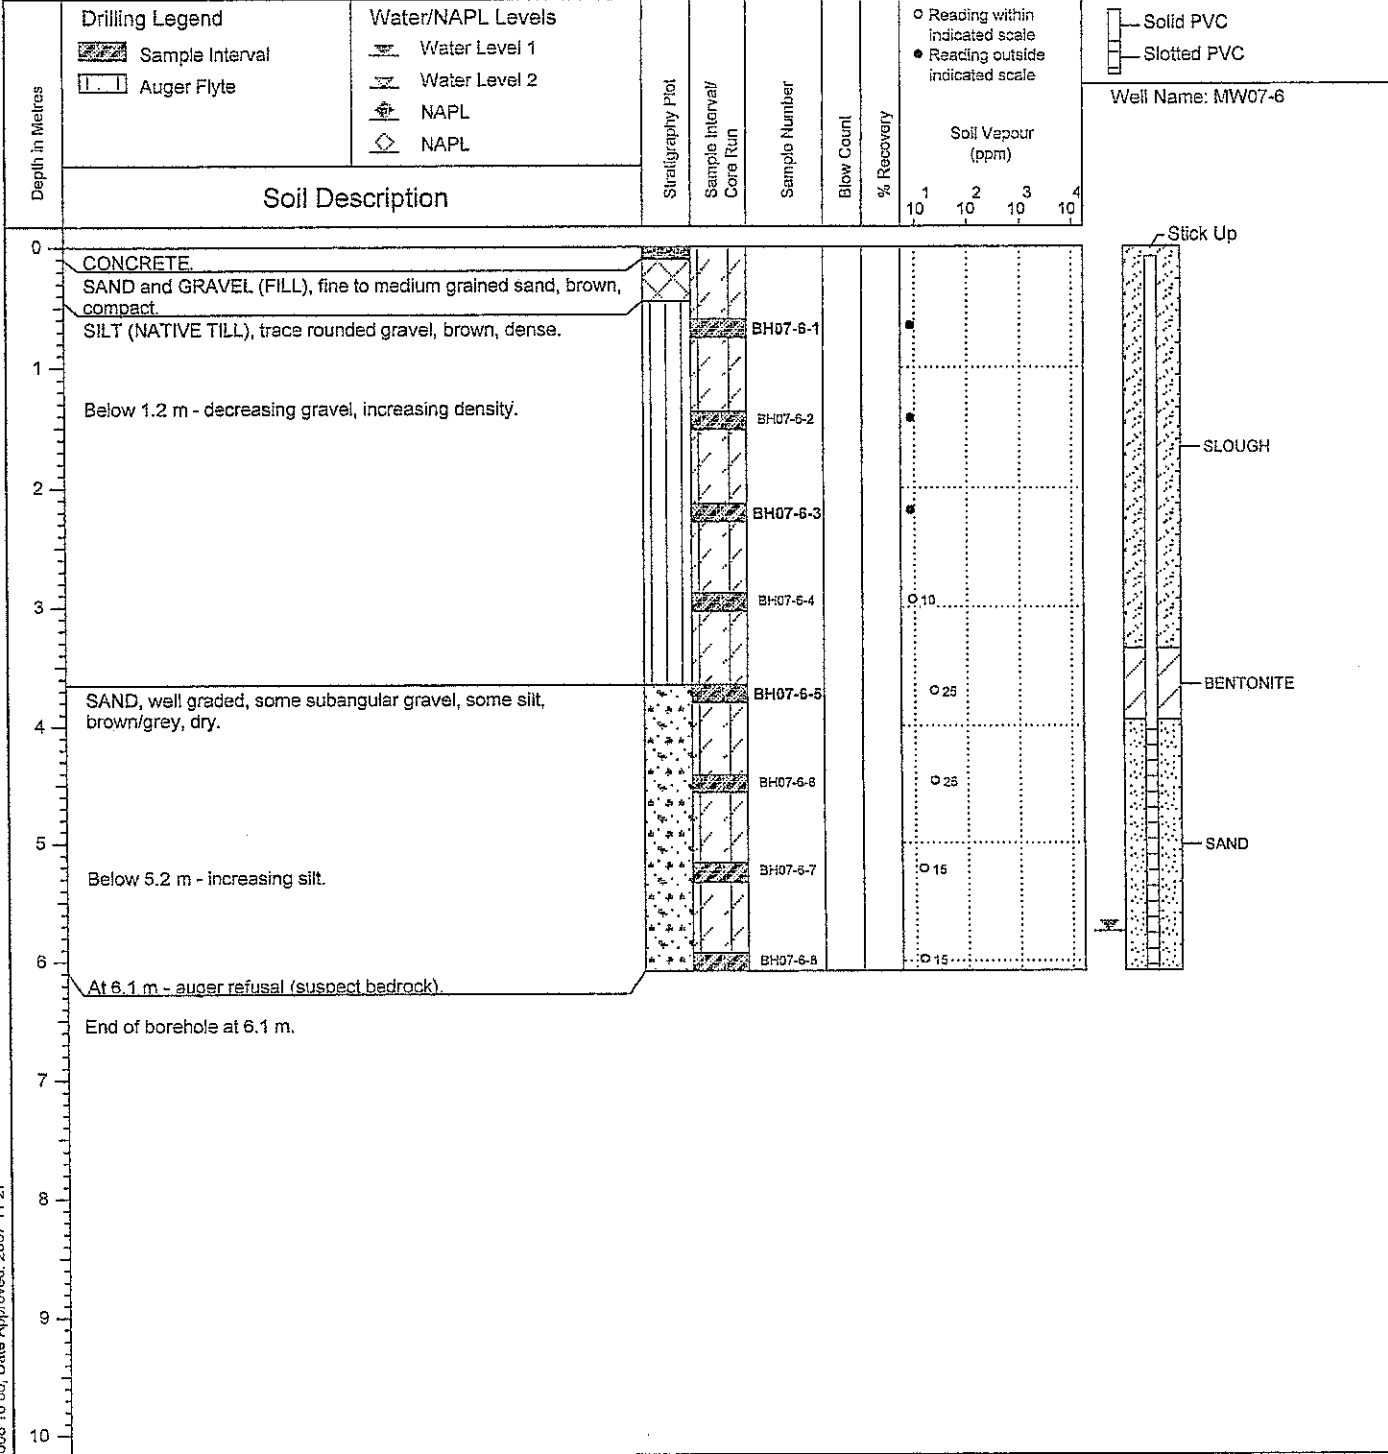

Notes:
Bolted sample denotes sample analyzed.