



SNC-LAVALIN
Environment

Client :
Shell Canada Products

Borehole No. : BH07-6


Location :
4264 Joyce Road, Powell River, BC

(Page 1 of 1)

Drilling Contractor: Drillwell Enterprises Ltd.
Drilling Method : Solid Stem Auger/Hollow Stem Auger
Borehole Dia. (m) : 0.15
Pipe/Slotted Pipe Dia. (m): 0.05, 0.05

Date Monitored : 2007 10 22
Ground Surf Elev. (m) : 47.21
Top of Casing Elev. (m) : 47.745

Project Number : 131935
Borehole Logged By : DF
Date Drilled : 2007 10 17
Log Typed By : MAL

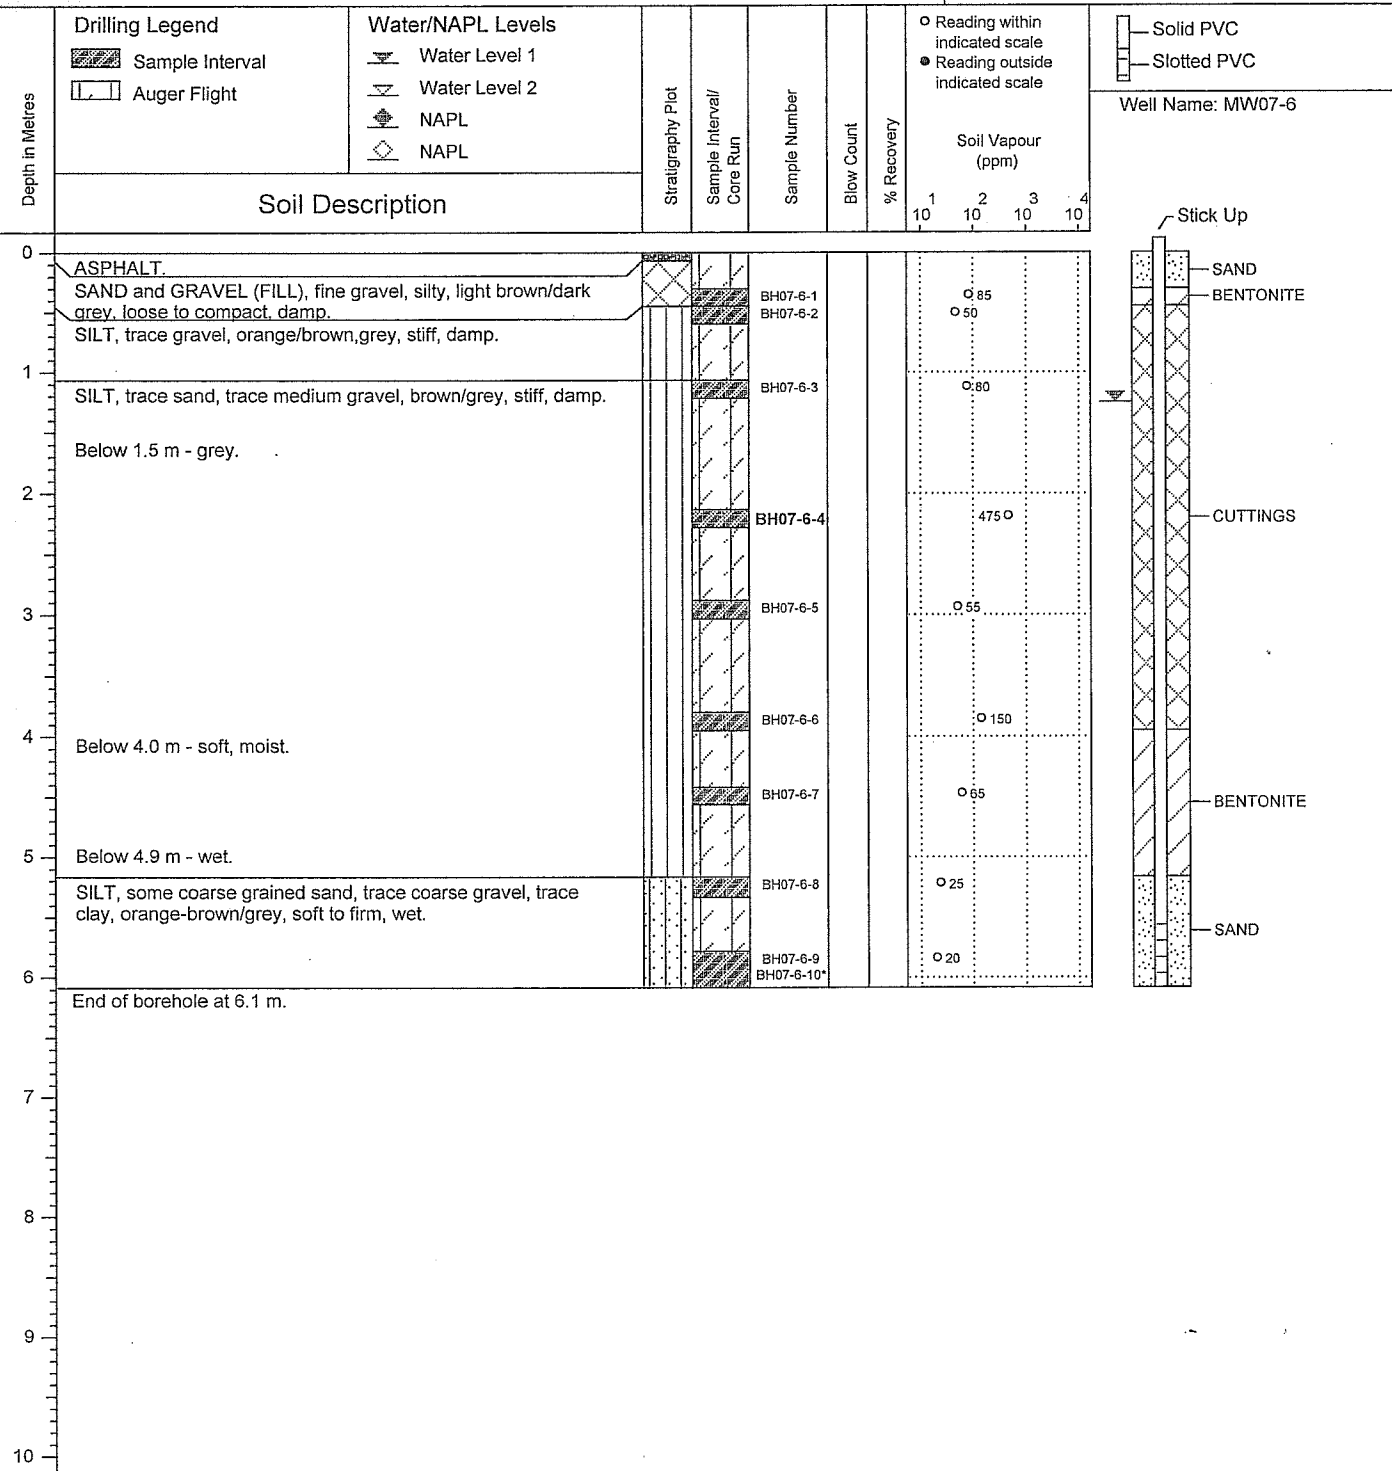

Print Date: 2009 09 29, Date Approved: 2007 11 29

Notes:
 Bolded sample denotes sample analyzed.
 *Sample BH07-6-10 is a blind field duplicate of BH07-6-9.