

PHOENIX
ENVIRONMENTAL SERVICES LTD.

103 - 1600 6th Ave., Vancouver, B.C.

DRILL LOG BH5/MW5

Fraser Seeds Ltd.
29461 Fraser Hwy.
Abbotsford, B.C.


Date: Jan. 27, 2010

BH/MW Location: E. of The Workshop

PVC Well Screen : 0.854 - 3.902
PVC Solid Casing : 0.092 - 0.854
Bentonite Seal : 0.15 - 0.61
Filter Sand Pack : 0.61 - 4.572
SIL-9 (Gravel Mix) : 4.572 - 6.096

End of Borehole : 6.096 mbgs
Drill Cutting : n/a
Well Diameter : 5 cm
Well Topped By : Road Box
Logged by : TV

Well: MW5
Elev.: n/a

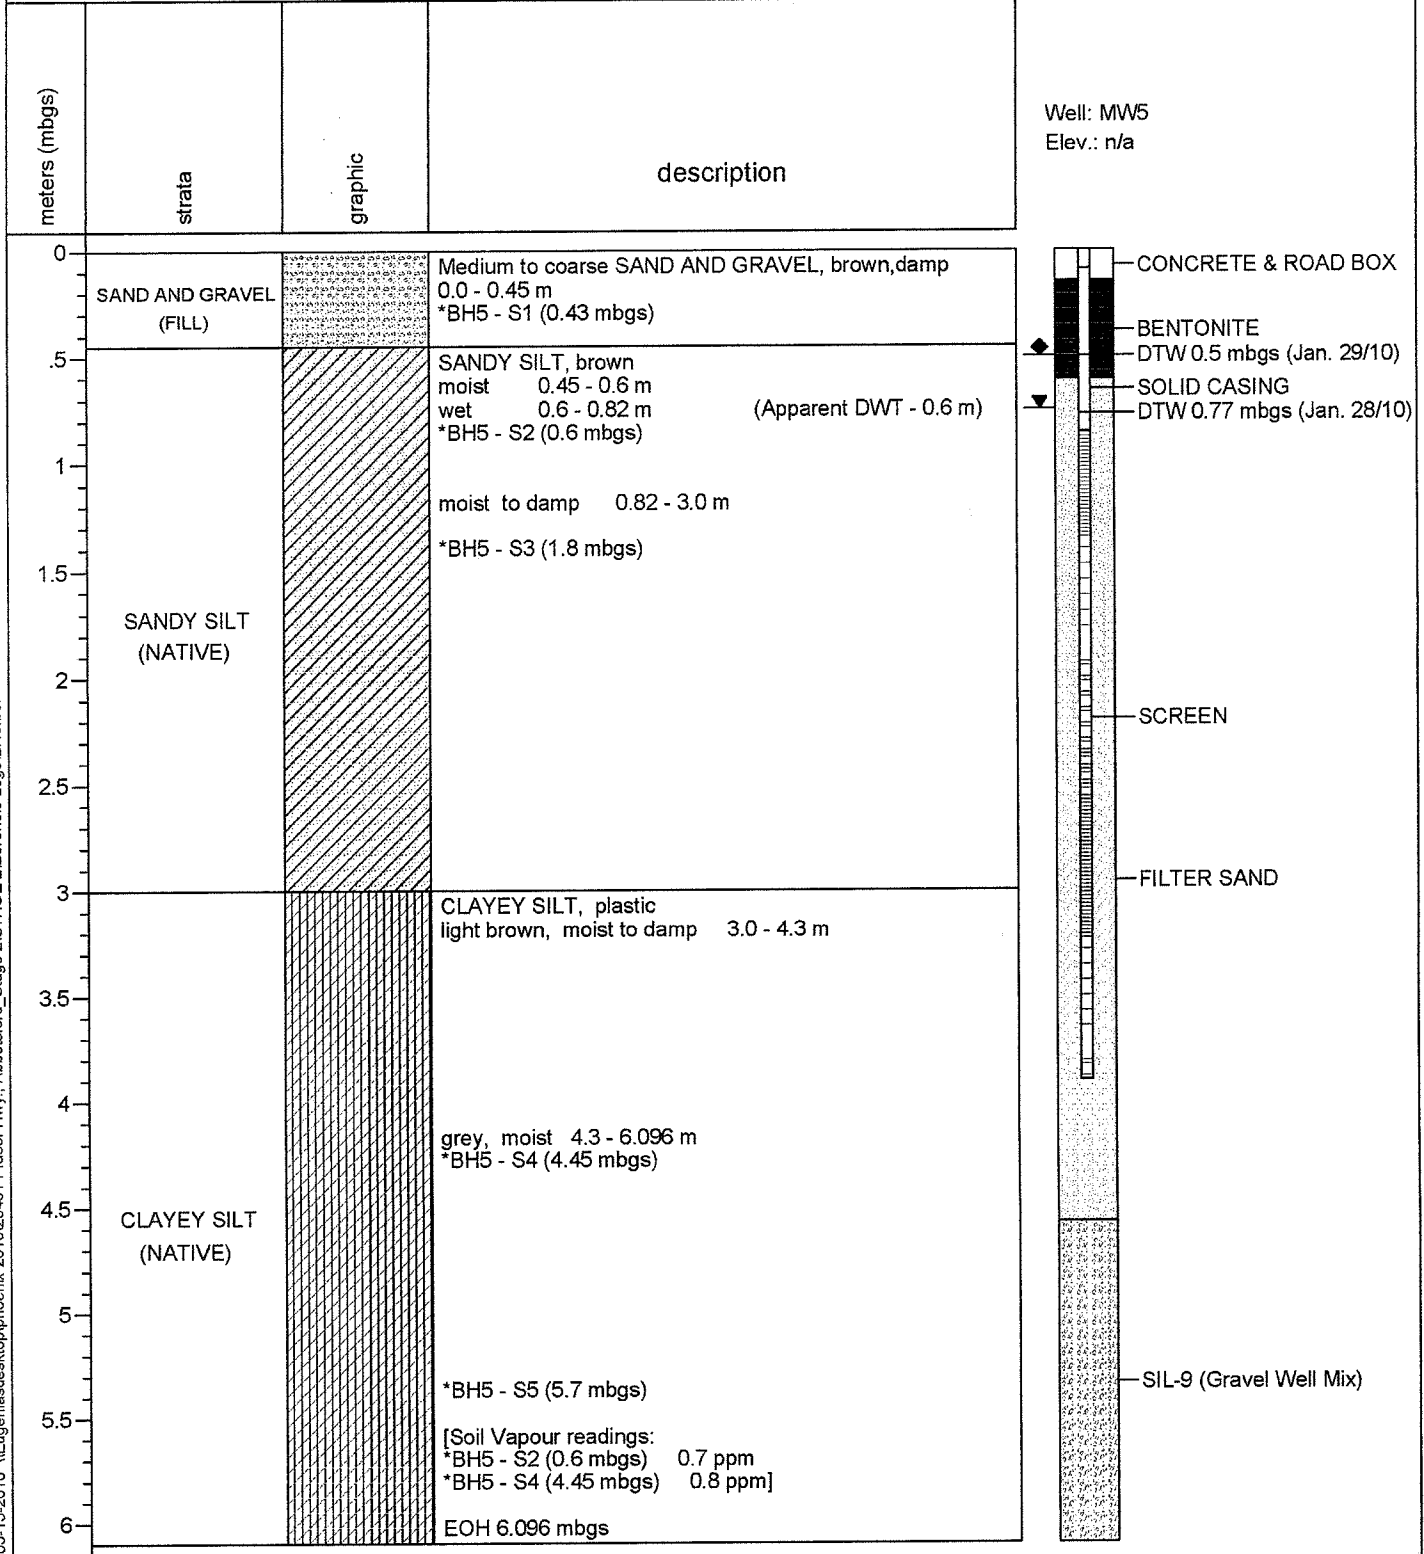

03-15-2010 \\Eugenia\desktop\phoenix_2010\29461 Fraser Hwy., Abbotsford_Stage 2\STAGE 2\Borehole_Logs\BH5.bor