


PROJECT: FORMER BAILEY'S ESSO SERVICE	TPC: 30.665	BORHOLE NO: BH3
LOCATION: VERNON, BRITISH COLUMBIA	GR: 30.207	JOB NO: 10-2666
CLIENT: IMPERIAL OIL PRODUCTS DIVISION	COMPLETION DATE: 93/11/15	DRILL: AUGER
SAMPLE TYPE <input type="checkbox"/> OTHER <input checked="" type="checkbox"/> SHELBY <input checked="" type="checkbox"/> SPLIT SPOON <input type="checkbox"/> CORE <input type="checkbox"/> DISTURBED <input type="checkbox"/> NO RECOVERY		

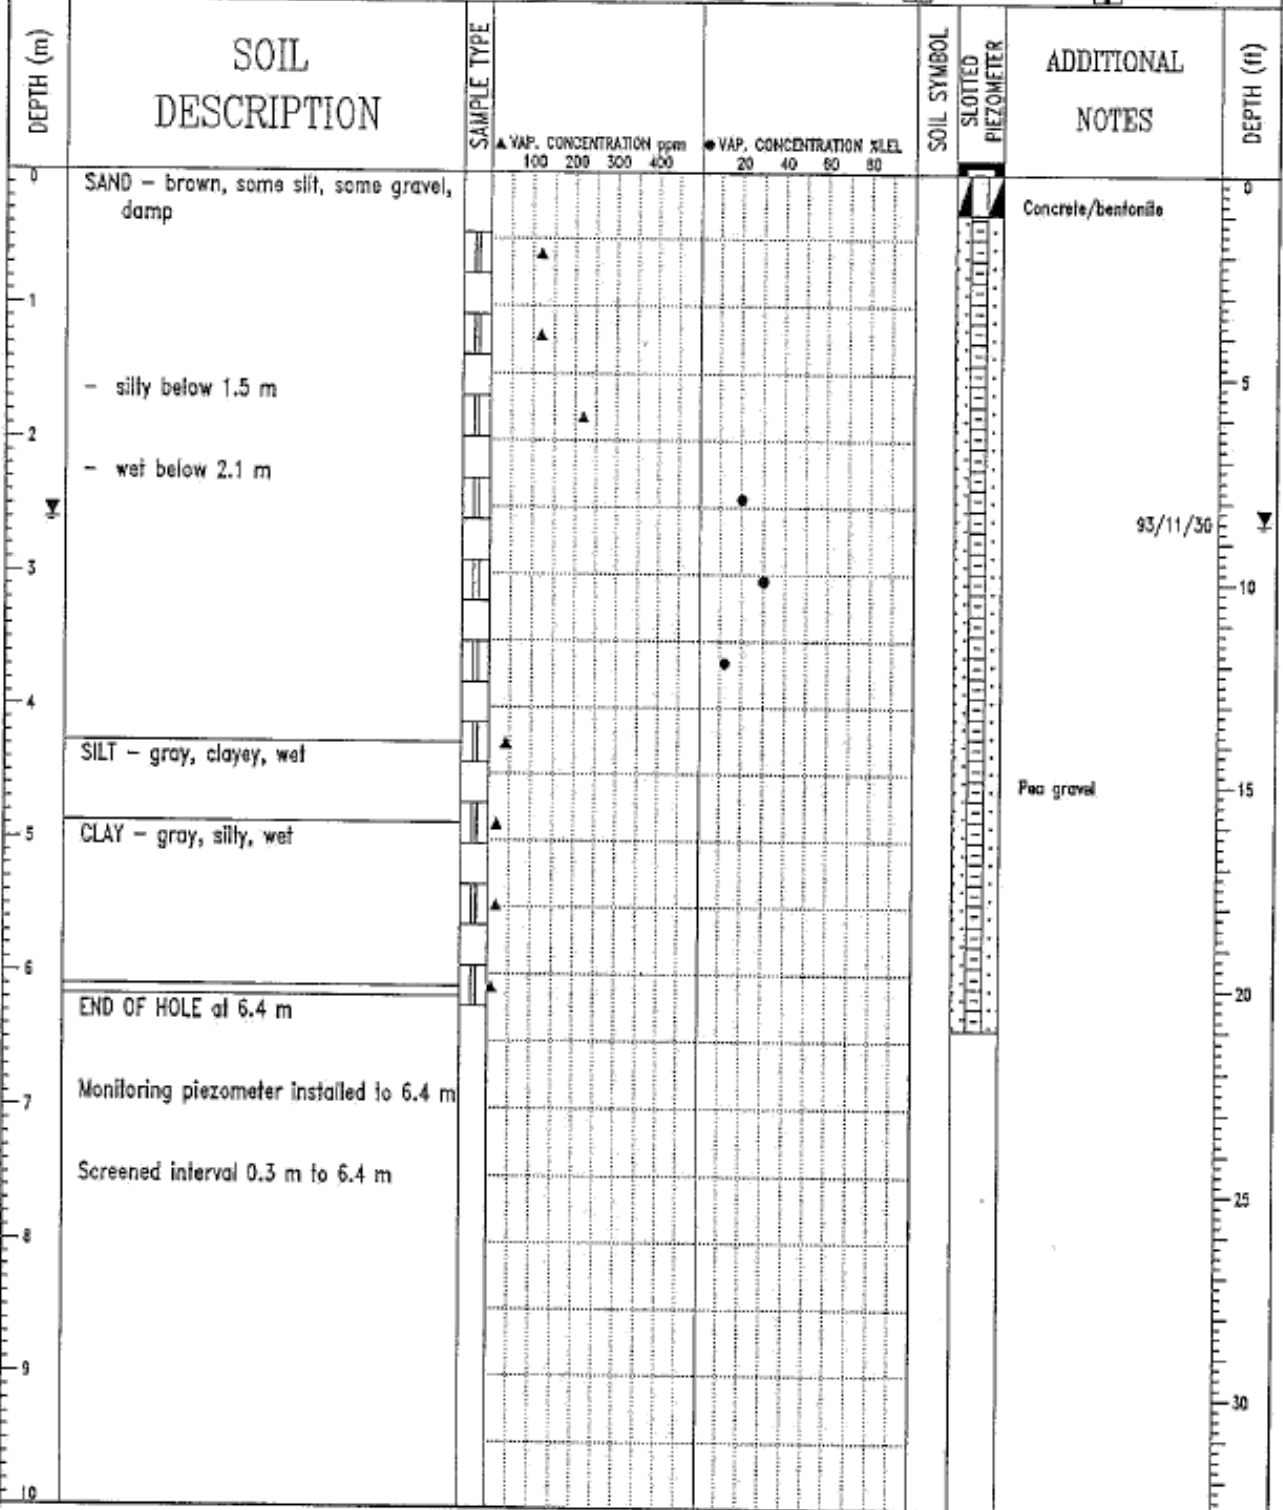

O'Connor Associates  
Vancouver, B.C.

LOGGED BY: GMD  
REVIEWED BY: APM  
DRAWING NO: A-5