


FINAL

SNC • LAVALIN	Client Canhusk Real Estate	Borehole No. : BH16-01
	Location 31648 S. Fraser Way, Abbotsford, BC	PAGE 1 OF 1

Drilling Contractor: Southland Drilling Company Drilling Method: Solid Stem Auger Borehole Dia. (m): 0.15 Pipe/Slotted Pipe Dia. (m): 0.05/0.05	Date Monitored: 2017 01 12 Ground Surface Elev. (m): 99.867 Top of Casing Elev. (m): 99.788 Northing: n/a Easting: n/a	Project Number: 640566 Borehole Logged By: AT Date Drilled: 2016 12 01 Log Typed By: SGP
--	--	---

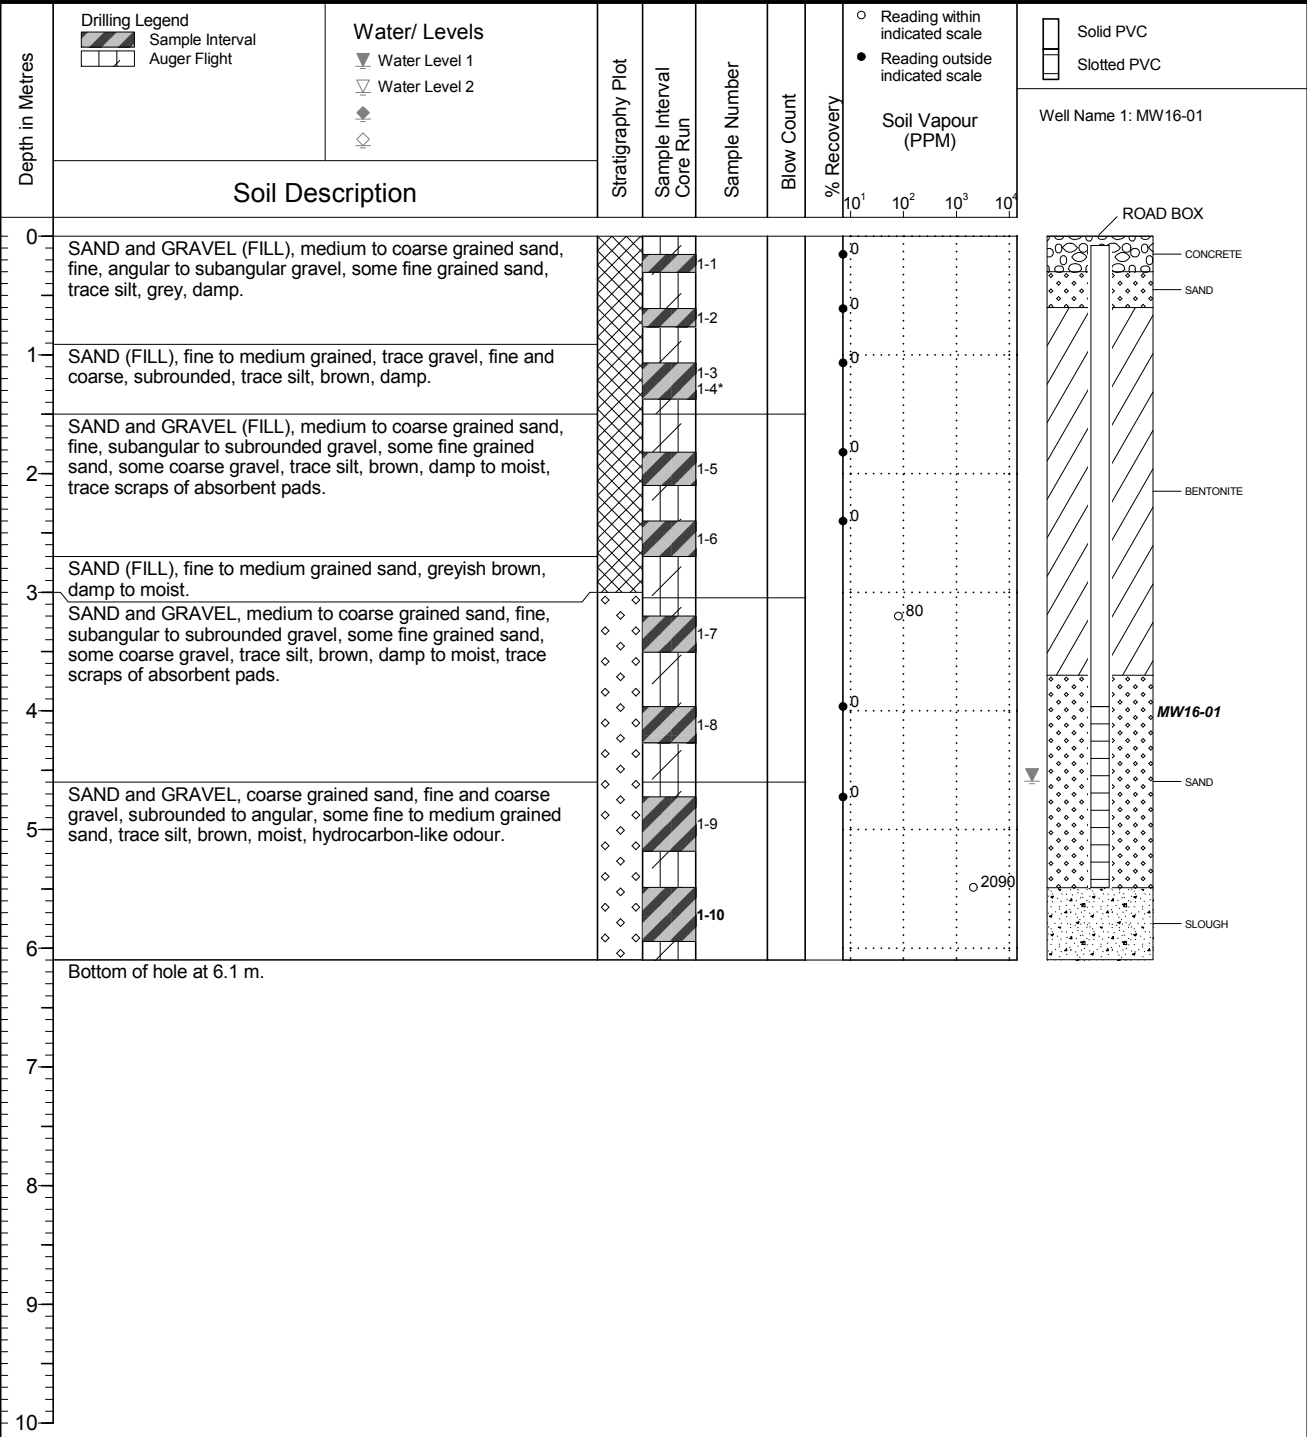

QA/QC: AT 2017 02 02 Print Date: 2017-09-27

Any use which a third party makes of this document, or any reliance on or decisions to be made based on it, are the responsibility of such third parties. CanHusk Real Estate ULC/SNC-Lavalin Inc./CSAP/ENV are not responsible for any use or modification of this document. CanHusk/SNC-Lavalin/CSAP/ENV accept no responsibility for damages, if any suffered by any third party as a result of decisions made or actions taken based on this document.

NOTES
 Bold denotes sample analysed.
 * Denotes blind field duplicate.