

CLIENT: SHELL CANADA PRODUCTS LTD.	DRILLING CONTRACTOR: ENVIROTECH DRILLING	PROJECT No.: R14-103
LOCATION: 18th & LONSDALE	DRILLING METHOD: SOLID STEM AUGER	DIAMETER: 150 mm
		BOREHOLE No.: 12D


SAMPLE TYPE: CORE SPLIT SPOON DISTURBED NO RECOVERY

ELEV. - DEPTH (m)	SOIL DESCRIPTION	STRATIGRAPHY PLOT	SAMPLE TYPE	SAMPLE NUMBER	HEADSPACE VAPOUR CONCENTRATION (ppm)				WATER LEVEL	MONITORING WELL INSTALLATION DETAILS
					10	100	1000	10000		
0	Brown, medium SAND and GRAVEL, trace cobbles, loose to compact, fill.									
1	- wet at 1.5 m.									
2										
3	Grey, fine to medium SAND, some cobbles and gravel, wet, dense.									
4										
5										
6	End of borehole @ 6.1 m.									
7										
8										
9										

120-S1 ▲

- LEGEND**
- road box
 - concrete seal
 - bentonite seal
 - 50 mm ϕ PVC pipe
 - 50 mm ϕ slotted PVC pipe
 - clean silica sand backfill
 - auger cuttings

MONITORED 94-09-12

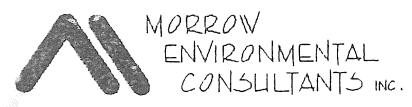

GROUND SURFACE ELEVATION: 9.161 m	DATE DRILLED: 94-09-07
TOP OF CASING ELEVATION: 9.595 m	LOGGED BY: R.J.
SHEET 3 OF 6	