




Client
B.C. Hydro and Power Authority
 Location
Rock Bay - Super Save Investigation, Victoria, BC

Borehole No. : BH14-595

PAGE 1 OF 1

Drilling Contractor: H2X/Blue Max/Drillwell	Date Monitored: 2014 12 08	Project Number: 616224
Drilling Method: Hydrovac/Vibratory Sonic/Geopr..	Ground Surface Elev. (m): 4.181	Borehole Logged By: JSE
Borehole Dia. (m): 0.15	Top of Casing Elev. (m): 4.122	Date Drilled: 2014 11 27
Pipe/Slotted Pipe Dia. (m): 0.05/0.05	Northing: 5364604.055	Easting: 472793.991
		Log Typed By: NDS

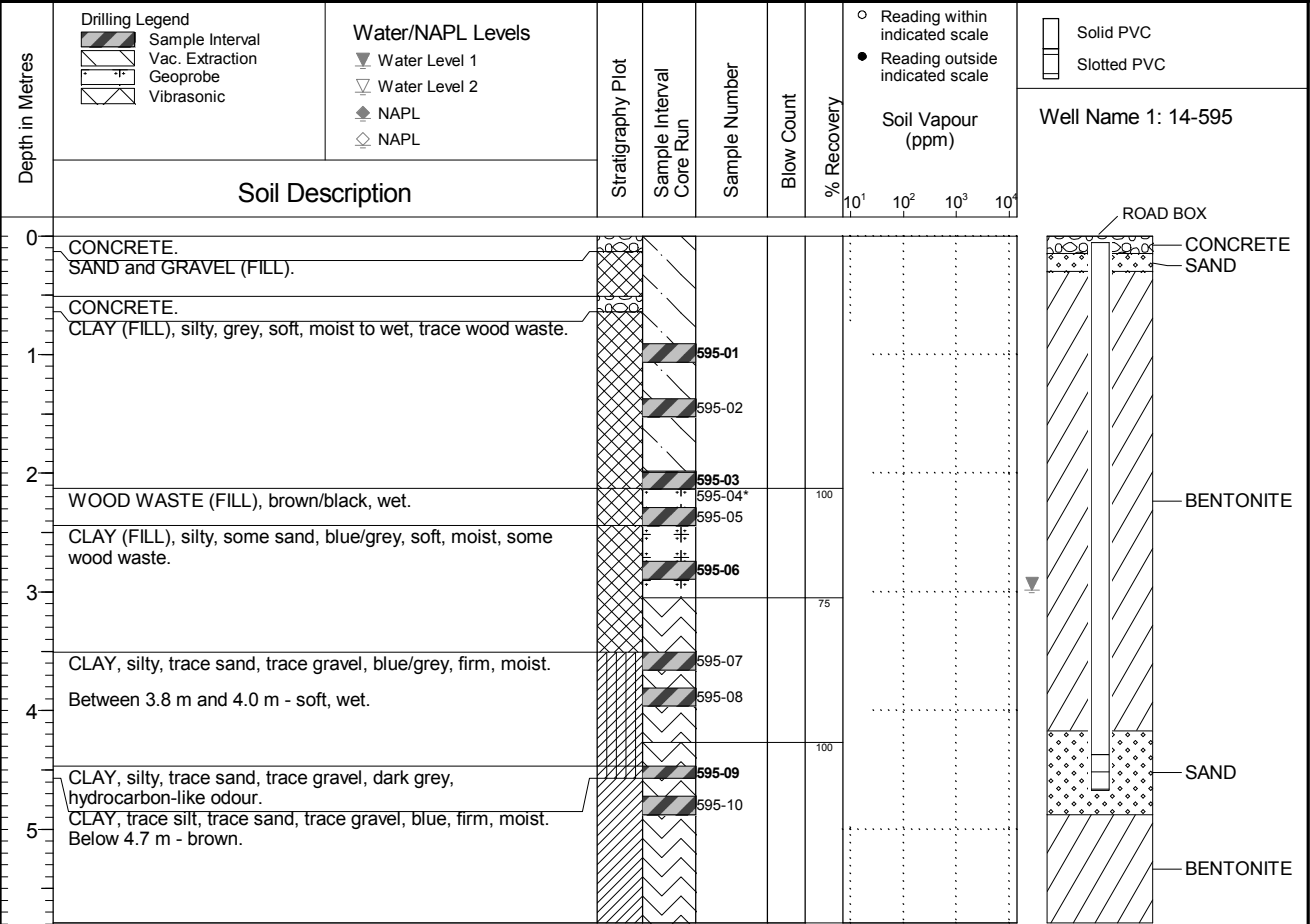

Any use which a third party makes of this document, or any reliance on or decisions to be made based on it, are the responsibility of such third parties. CSAP/MOE are not responsible for any use or modification of this document. CSAP/MOE accept no responsibility for damages, if any, suffered by any third party as a result of decisions made or actions taken based on this document.

NOTES

Bolded sample denotes sample analyzed.
 * denotes blind field duplicate.
 595-04 is a blind field duplicate of 595-03.
 Borehole advanced to a depth of 3.1 m on 2014 11 26.