


Monitoring Well: MW16-01

Project: Remedial Confirmation
Client: Greater Victoria Rental Development Society
Location: 1950 Blanshard Street, Victoria, BC
Number: 123210213
Field investigator: AM
Contractor: Western Grater

Drilling method: Solid Stem Auger/ Downhole hammer
Date started/completed: 03-May-2016
Ground surface elevation: 101.08 m AMSL
Top of casing elevation: 100.92 m AMSL
Easting: n/a
Northing: n/a

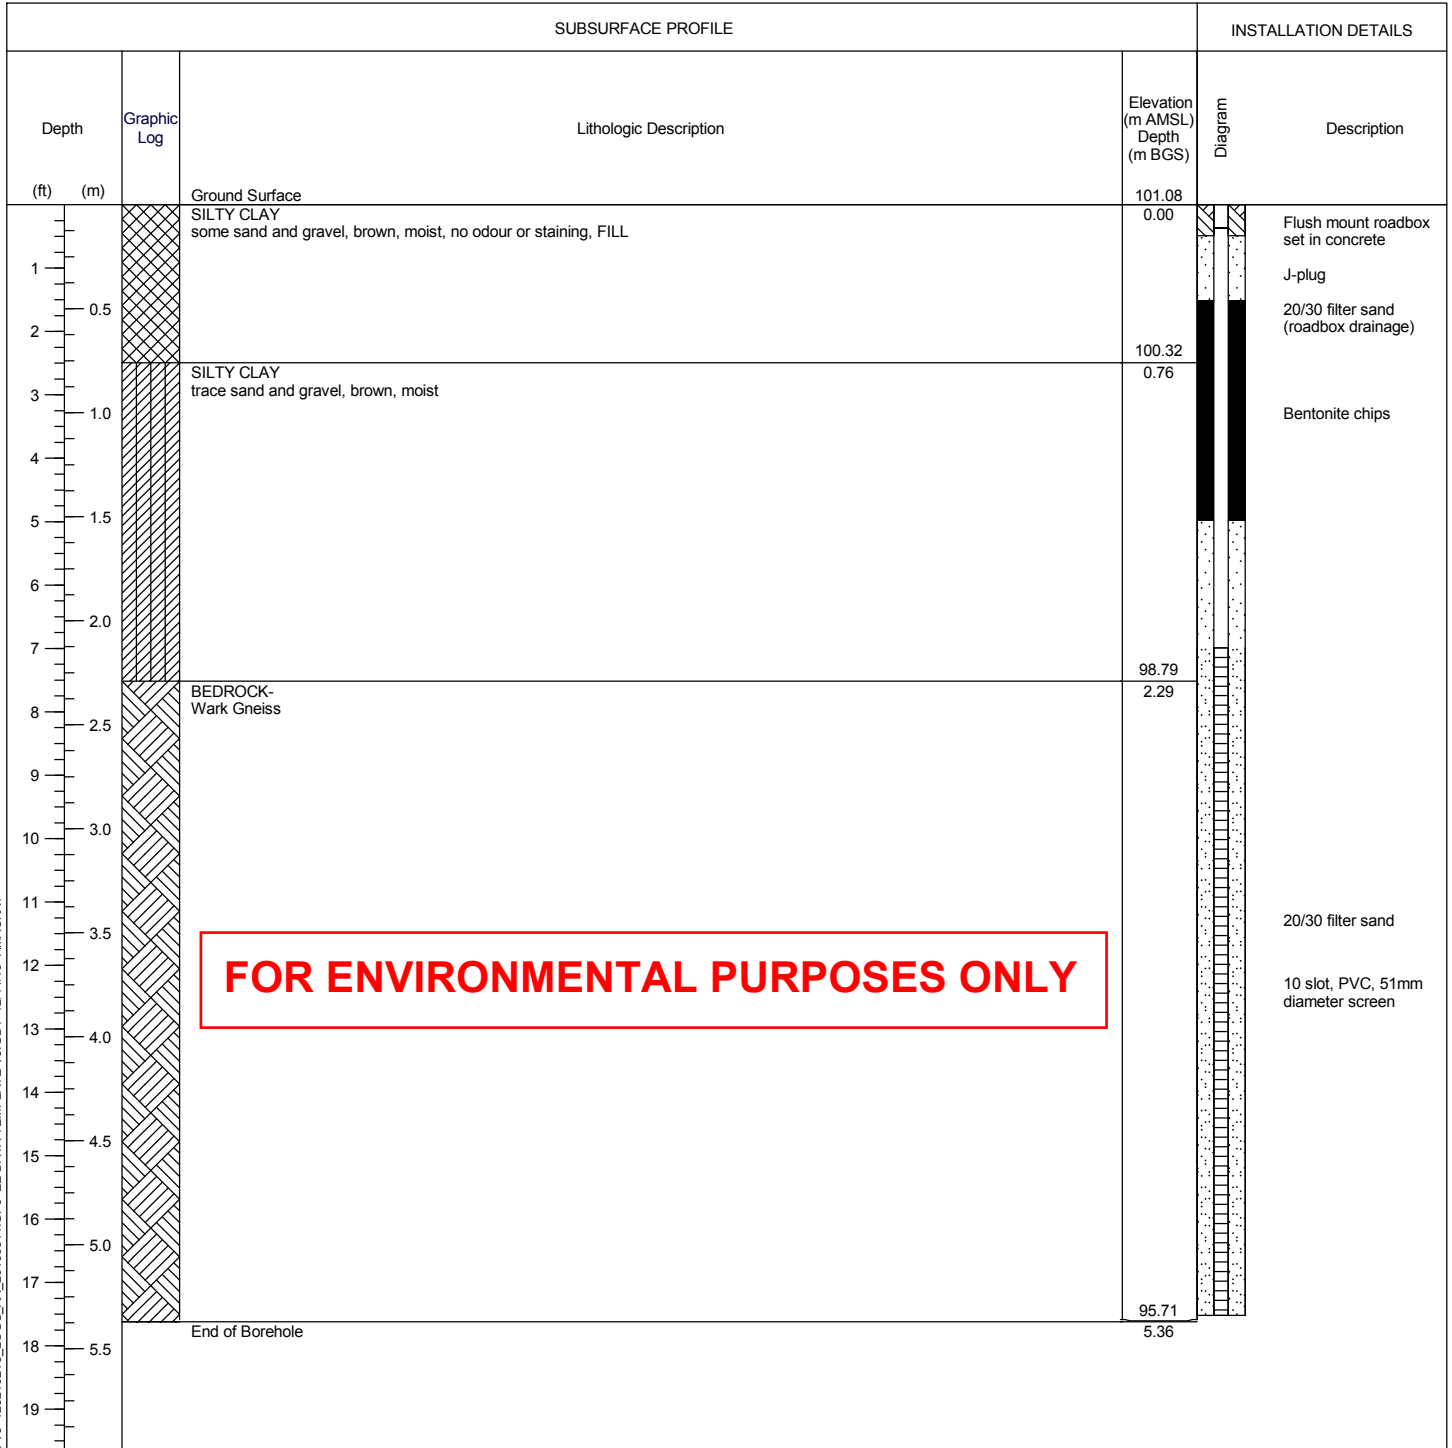

Screen Interval: 2.13 - 5.34 m BGS
 Sand Pack Interval: 2.13 - 5.34 m BGS
 Well Seal Interval: 0.46 - 1.52 m BGS

Notes:
 m AMSL - metres above mean sea level
 m BGS - metres below ground surface
 n/a - not available

Elevations were surveyed relative to an assigned elevation (100.000 m)

STANTEC BOREHOLE AND WELL V5 123210213_LOGS_AA_20160511.GPJ_EE DATA TEMPLATE V5.GDT 12/14/16 AMACKAY