



Client  
Ministry of Transportation and Infrastructure

Borehole No. : 13-1


Location  
1101 Mission Flats, Kamloops

PAGE 1 OF 2

Drilling Contractor Geotech Drilling Services Ltd.  
Drilling Method Odex/Split Spoon  
Borehole Dia. (m) 0.10  
Pipe/Slotted Pipe Dia. (m) 0.05/0.05


Date Monitored 2013 10 21  
Ground Surface Elev. (m) 355.350  
Top of Casing Elev. (m) 355.316  
Northing: 5617826.539 Easting: 685811.063

Project Number: 511068  
Borehole Logged By: MC  
Date Drilled: 2013 07 25  
Log Typed By: CD

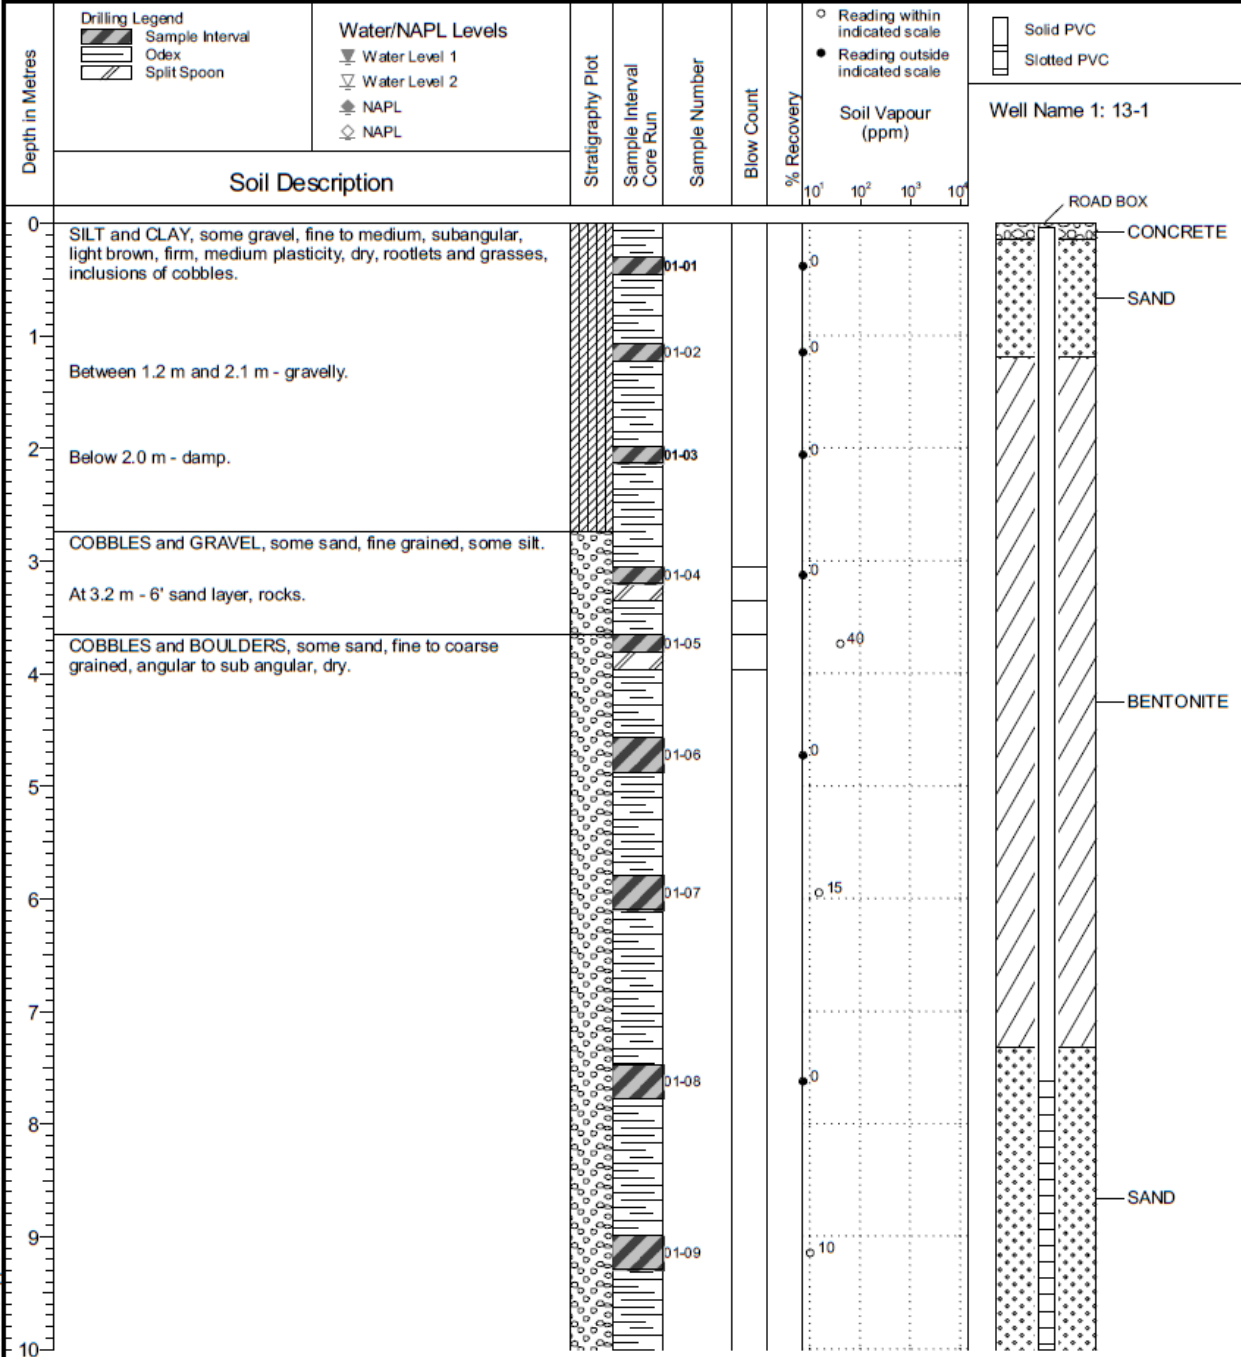

**NOTES**  
 Bolded sample denotes sample analyzed.

Drilling Contractor: Geotech Drilling Services Ltd. Drilling Method: Odex/Spilt Spoon Borehole Dia. (m): 0.10 Pipe/Slotted Pipe Dia. (m): 0.05/0.05	Date Monitored: 2013 10 21 Ground Surface Elev. (m): 355.350 Top of Casing Elev. (m): 355.316 Northing: 5617826.539    Easting: 685811.063	Project Number: 511068 Borehole Logged By: MC Date Drilled: 2013 07 25 Log Typed By: CD
--	---	--

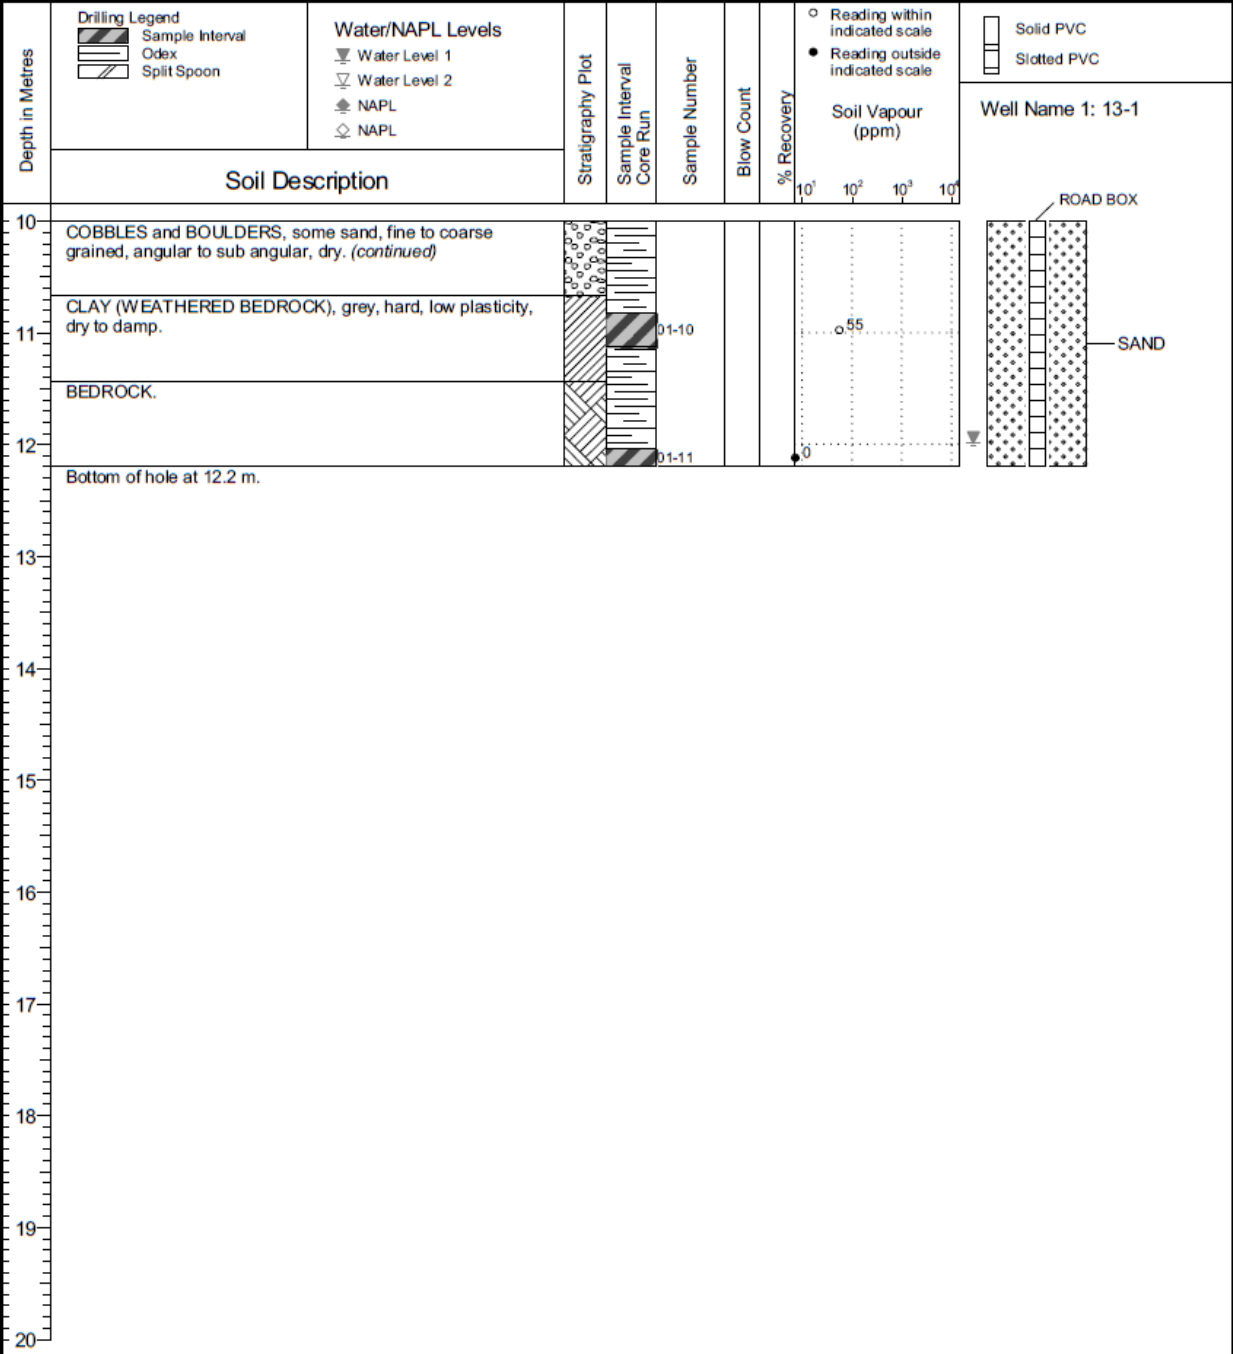

**NOTES**  
 Bolded sample denotes sample analyzed.