


BOREHOLE LOG

PROJECT: Environmental Site Assessment	REF. NO: 10-1864	BOREHOLE NO: BH19
LOCATION: 1206 North 12th Street, Golden, British Columbia	TPC ELEV.: 797.19 masl	START DATE: 2012/10/31
CLIENT: Imperial	GRADE ELEV.: 797.26 masl	COMPLETION DATE: 2012/11/14
BENCHMARK: Geodetic Benchmark 68C137 ELEV: 787.464 m		PAGE 1 of 1

Depth (m) Water Level	STRATIGRAPHY DESCRIPTION	MATERIAL TYPE	SAMPLING				▲ SOIL VAPOUR CONCENTRATION (ppmv) 100 200 300 400	◆ SOIL VAPOUR CONCENTRATION (%LEL) 20 40 60 80	COMMENTS AND MONITORING WELL NOTES	MONITORING WELL	MONITORING WELL	Depth (ft) Water Level
			NUMBER	SAMPLE TYPE	'N' VALUE	RECOVERY %						
0	SILT - brown, some sand, trace cobbles, trace gravel, damp											0
6	SAND AND SILT - brown, some gravel, trace cobbles, trace clay, dry											6
12	SAND - brown, some silt, some gravel, trace cobbles, dry											12
15.5	- gravelly, wet below 15.5 m											15.5
21	END OF HOLE AT 21.0 m											21
<p>Any use which a person makes of this data, or any reliance on or decisions to be made based on it, are the sole responsibility of such person. Imperial Oil/Parsons/CSAP/MOE are not responsible for any use or modification of this data. Imperial Oil/Parsons/CSAP/MOE accept no responsibility for losses or damages, if any, suffered by any person as a result of decisions made or actions taken based on this data.</p>												

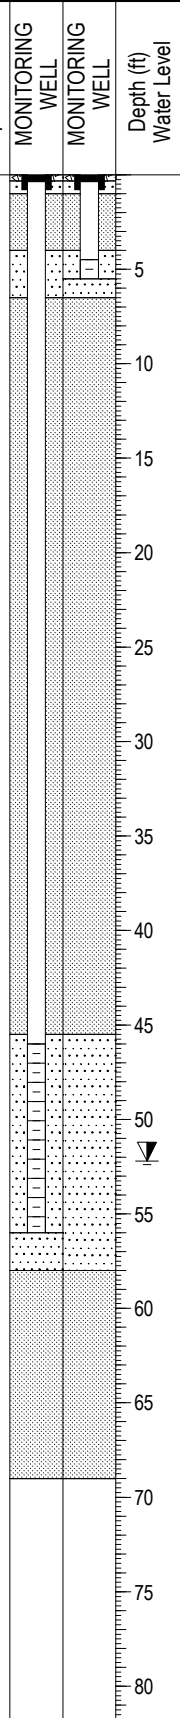

FOR BC/MOE - IMPERIAL ONLY 10-1864.GPJ SOIL LOG (REV 2).GDT 9/13/15



LOGGED BY: LCL	DAYLIGHTING TO: 1.2 m	GAS METER TYPE: RKI Eagle
REVIEWED BY: JAB	EQUIPMENT: Hydro-Excavator/Track Mounted DB320	
DRAFTED BY: CAB	METHOD: Hydrovac/Sonic	BOREHOLE DIA.: 15 cm