

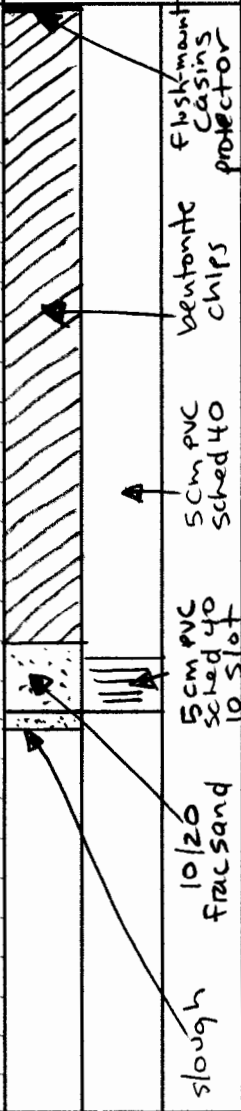
Borehole / Well Log

Project: Stage 1 & 2 PSI	Project Number: 212-15.1	Date: February 11, 2015	Sample Location ID: MW 2
Site Address: 1403 Victoria Rd, Revelstoke, BC		Drilling Contractor: OTM Locates	Drill Rig Type: ODEX
Location On Site: west boundary		Logged By: RL	Diameter: 10 cm

Depth (m)	Sample Interval	Sample Number	Unit	VOC (ppm)	Description	Closure Completion
2		1		0.3	0-1.16 m sand and gravel (poorly graded) orange brown, loose, dry to damp	flush-mount casing protector
		2		0.0		
		3		0.0		
		4		0.0		
4		5		0.3		
		6		0.3		
		8		0.0		
8		9		0.2		
		10		0.0		
10		11		0.0	- wet at 16.0 m	
		12		0.0		
12		13		0.0		
		14		0.0		
14		15		0.5		
		16		0.5		
18						10/20 frac sand
20						slough

Borehole / Well Log

Project: Stage 1 & 2 PSI	Project Number: 212-15.1	Date: February 11, 2015	Sample Location ID: MW3
Site Address: 1403 Victoria Rd, Revelstoke, BC		Drilling Contractor: OTM Locates	Drill Rig Type: ODEX
Location On Site: <i>east side</i>		Logged By: RL	Diameter: 10 cm

Depth (m)	Sample Interval	Sample Number	Unit	VOC (ppm)	Description	Closure Completion
2		1		0.7	0 - 6.19 m sand and gravel (poorly graded) orange brown. loose, dry to damp	
		2		0.4		
		3		0.7		
		4		0.3		
4		5		0.3	6.19 - 18.29 m fine sand, orange brown. compact, dry - wet at 16.5 m	
		6		0.3		
6		7		0.1		
		8		0.0		
8		9		0.3		
		10		0.5		
10		11		0.3		
		12		0.3		
12		13		0.3		
		14		0.4		
14		16		0.5		
16		15		1.1		
18						

Borehole / Well Log

Project: Stage 1 & 2 PSI	Project Number: 212-15.1	Date: February 11, 2015	Sample Location ID: MW1
Site Address: 1403 Victoria Rd, Revelstoke, BC		Drilling Contractor: OTM Locates	Drill Rig Type: ODEX
Location On Site: west side		Logged By: RL	Diameter: 10 cm

Depth (m)	Sample Interval	Sample Number	Unit	VOC (ppm)	Description	Closure	Completion
0		1		0.4	0 - 1.07 m		
2		2		0.0	Sand and gravel (poorly graded) orange brown, loose, dry to damp		flush-mount casing protector
		3		0.4			
		4		0.0			
4		5		0.0			
		6		0.0			
6		7		0.3	1.07 - 5.18 m		
		8		0.0	Silty fine sand, medium grey compact, dry to damp		bentonite chips
8		9		0.0			
		10		0.1			
10		11		0.1	5.18 - 18.29 m		
		12		0.0	fine sand, orange brown, compact, dry		5cm PVC sched 40
12		13		0.0			
		14		0.0	- wet at 16.0 m		5cm PVC sched 40 10 slot
14		16		0.0			
		15		2.7			
16							
18							
20							
							slough 10/20 frac sand