


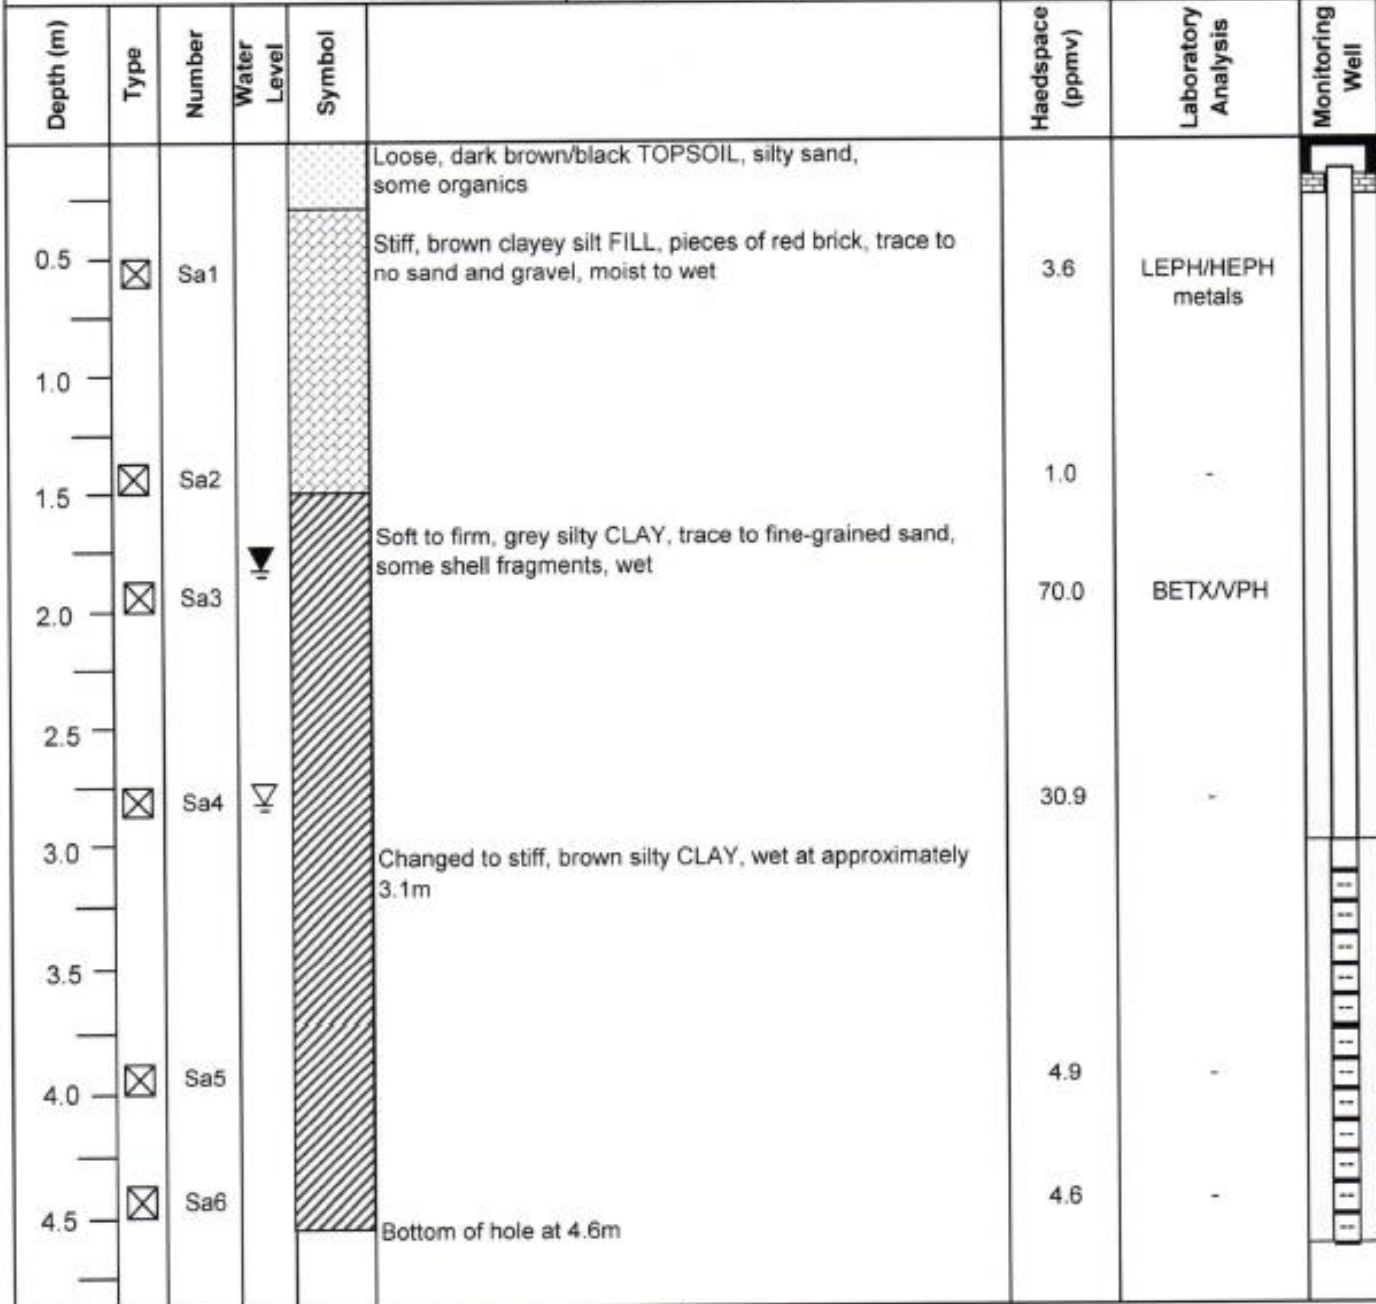

BH1

Project: Stage 2 PSI	Project No.: VI17-09	Client: Old Town Ironworks Inc.	Date: 20-Apr-17
Address: 533 Chatham Street, Victoria, BC		Contractor: Blue Max	Rig Type: Track
Logged By: Eric Gauvin		Drill Method: Auger	Dia. 150mm
		GW Depth: 1.80mbgs	Elev. n/a



- Standard Penetration Slit Spoon Sampler (SPT)
 Stabilized Groundwater - 24 April 2017
- California Sampler
 Bulk/ Bag Sample
 Groundwater At time of Drilling - 20 April 2017
- Shelby Tube
 CPP Sampler
- Concrete/Asphalt
 Clay
 Silt
 Sand and Gravel
- Sand
 Topsoil
 Fill