



Pottinger Caherty
Environmental Consultants Ltd.

LOG OF BORING BH2MA / B

(Page 1 of 1)

Westminster Management Corporation
3600 Lysander Lane
Richmond, BC


PGL File #: 2517-01.02

Installation Date : June 6, 2005
Contractor : TriTech Drilling
Drill Type : Hollow Stem Auger/SPT
Logged By : Bryan Brassington
Well Installed : Yes

Elevation (Surface) : 1.66
Elevation (TOC) : 2MA - 1.66 / 2MB - 1.63
Elevation (Water) : 2MA - 0.16 / 2MB - 0.27
DTW (from TOC) : 2MA - 1.50 / 2MB - 1.37
Well Type : PVC (2" diameter)

DEPTH (m)	USCS	GRAPHIC	DESCRIPTION	SAMPLES	SAMPLE NAME	REMARKS
Water Level ▼ July 20/05 (2MA) ▽ July 20/05 (2MB)			List of Acronyms TOC: Top of PVC Casing DTW: Depth to Water from TOC			
0			Brown SAND, dry, loose, with roots down to 0.3m.			
1	SP					
2			Dark grey SILT, some clay, moist, compact.	X	BH2-1	
3	ML			X	BH2-2	
4			Dark grey silty SAND, wet, compact.	X	BH2-3	
5	SM			X	BH2-4	
6			Grey SAND, some silt, wet, compact	X	BH2-5	
7	SP		Moist.	X		
7			End of Hole.			
8						
9						
10						

Well1: BH2MA
Well2: BH2MB
Elev: 2MA - 1.66 / 2MB - 1.63

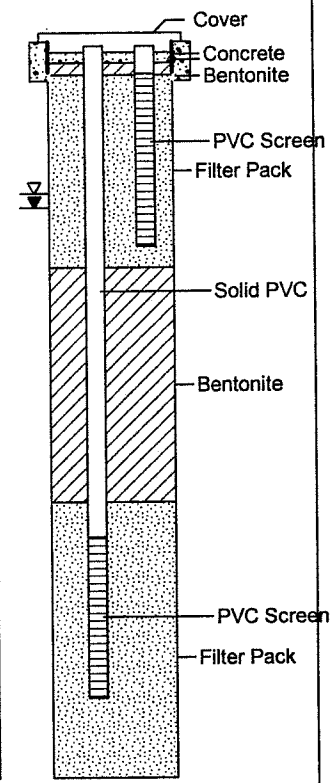

08-08-2005 T:\2400-2599\2517 Westminster Management\01.02 Lysander Lane - RA\FIELD Work\Borehole logs\BH2MAandB.bor