

## Borehole Log: BH13


**Project No.:** 2576-1303

**Project:** 350 Prideaux Street DSI

**Client:** B.C. Housing Management Commission

**Location:** 350 Prideaux Street, Nanaimo, BC

**Logged By:** J. Mathie

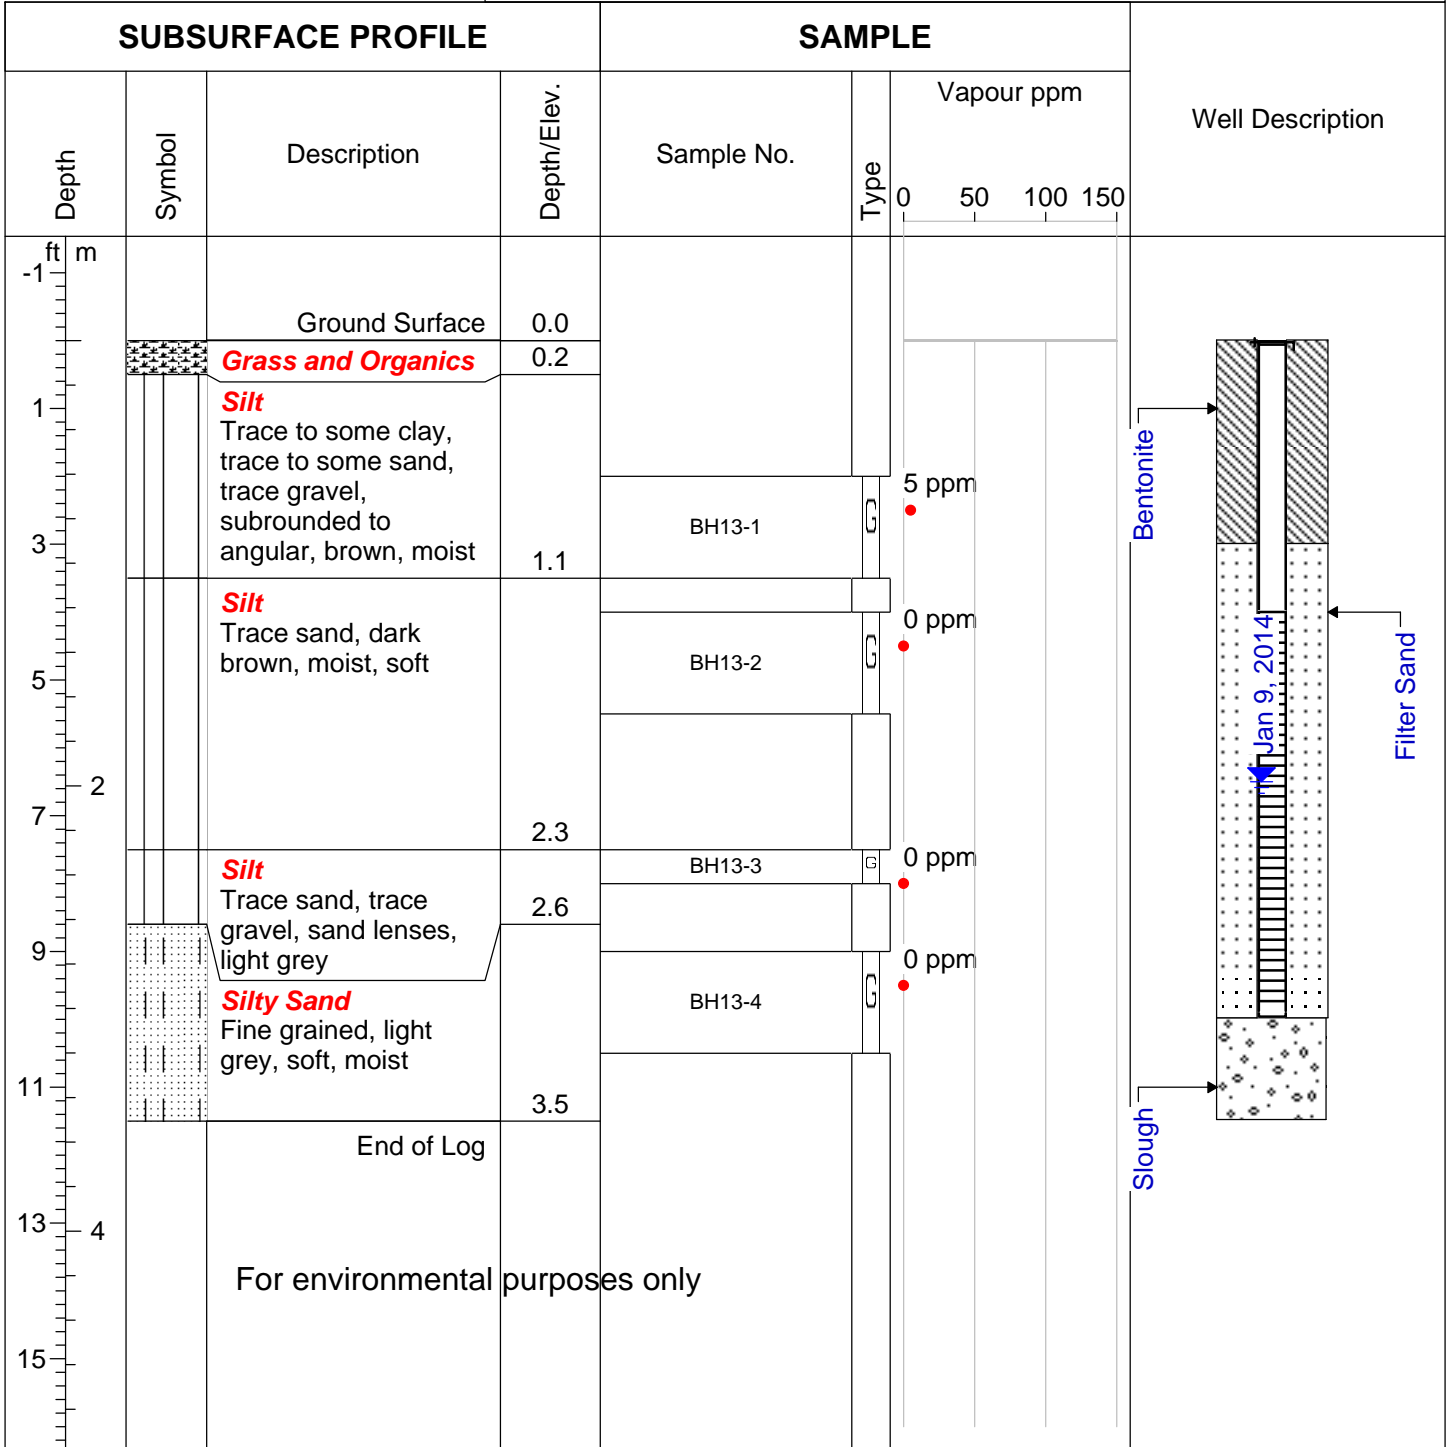

**Drilled By:** Blue Max Drilling Inc.

**Drill Method:** Solid Stem Auger

**Drill Date:** January 8, 2013

**Well Dia:** 1" / 2.5 cm

**Hole Dia:** 4" / 10 cm

**Sheet:** 1 of 1

**Version:** V0.1