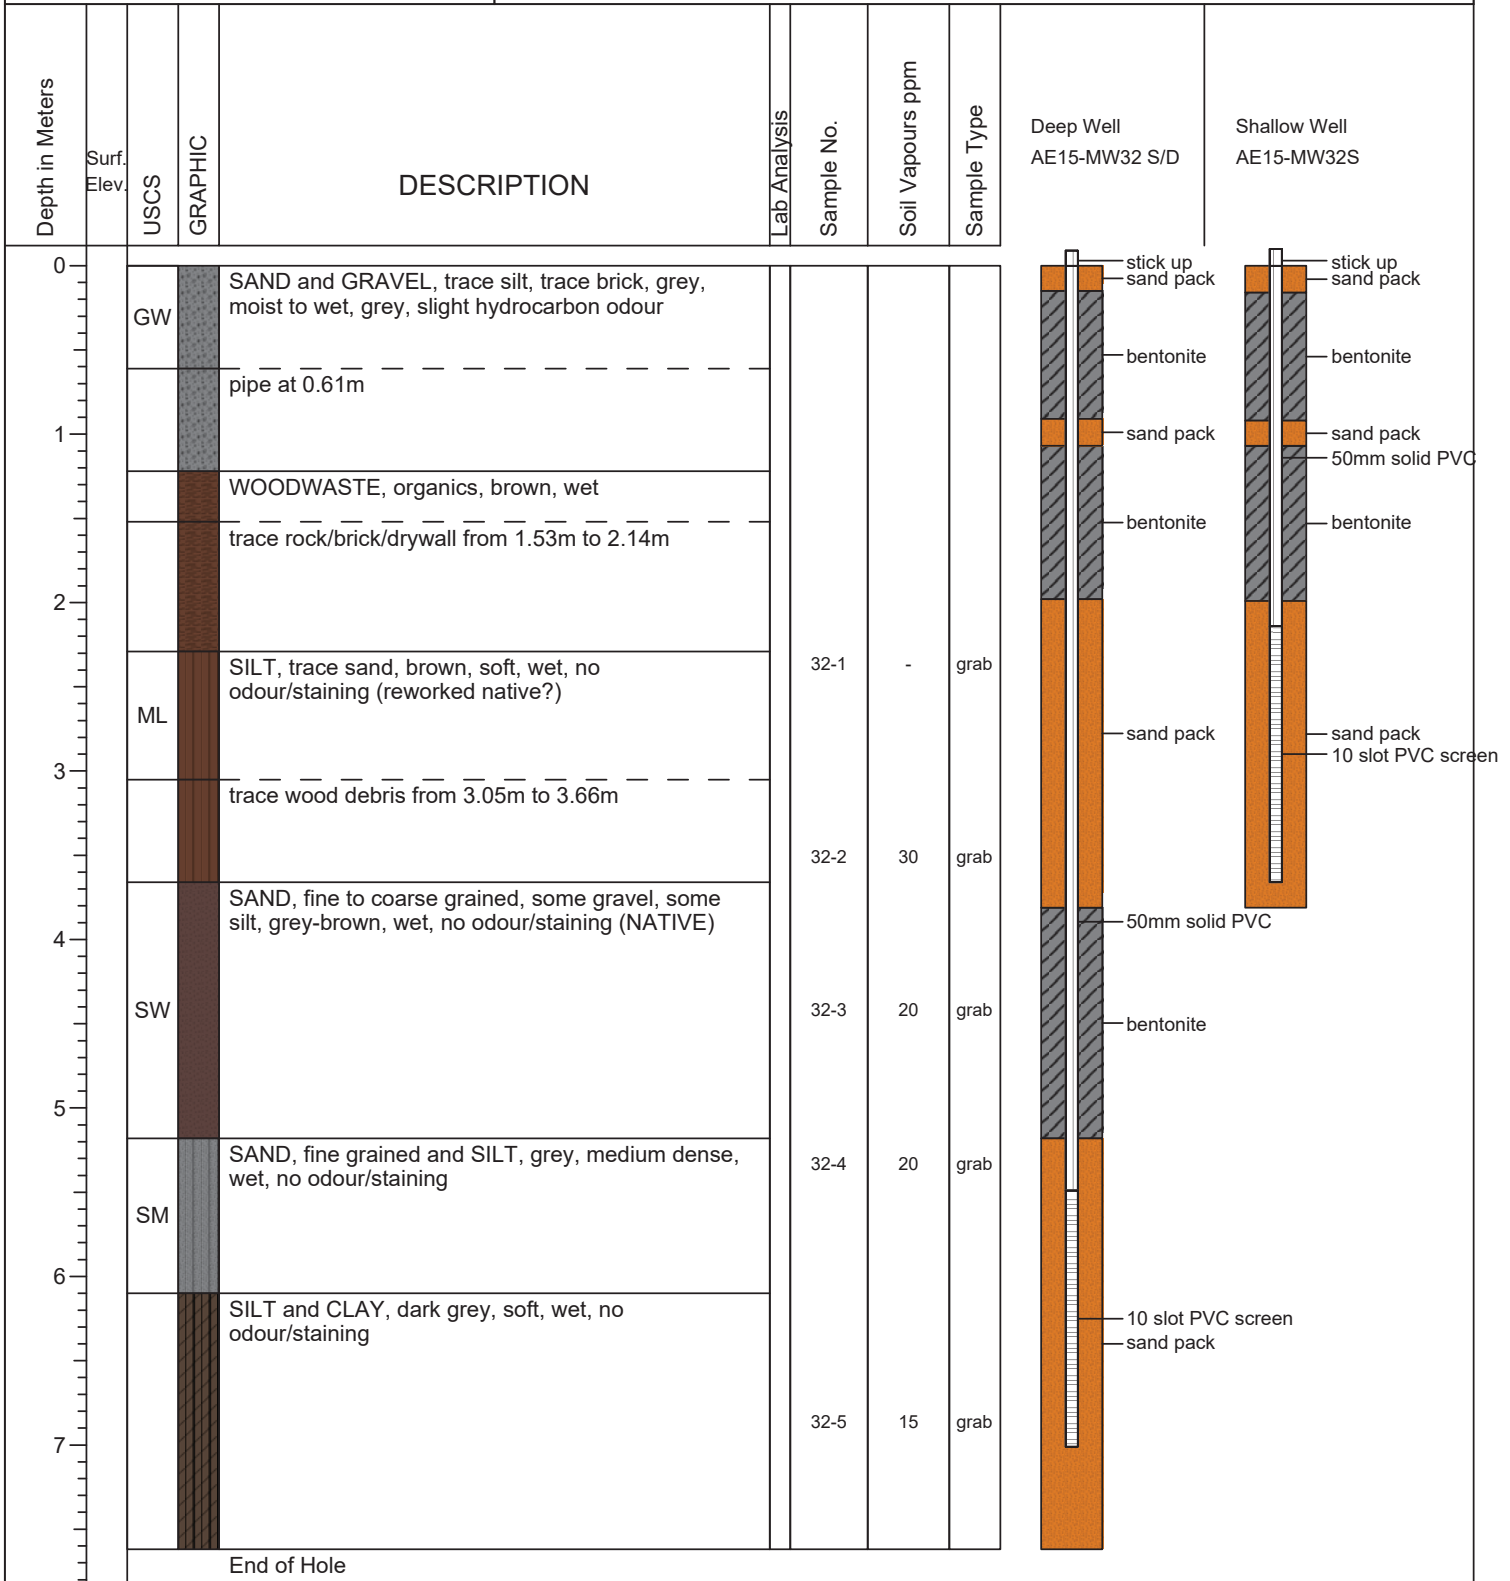


2794 Aberdeen Avenue
 Coquitlam, BC

Project 901

 Date Started : May 14, 2015
 Date Completed : May 14, 2015
 Hole Diameter : 152mm
 Drilling Method : Hollow Stem Auger
 Sampling Method : Grab

 Company Rep. : SB
 Lab Analysis : *indicates sent for analysis
 Drilled By : Uniwide Drilling
 Logged By : SB


Any use which a third party makes of this document, or any reliance on or decisions to be made based on it, are the responsibility of such third parties. CSAP/MOE are not responsible for any use or modification of this document. CSAP/MOE accept no responsibility for damages, if any, suffered by any third party as a result of decisions made or actions taken based on this document.