

Project Name: EAG Stewart

MONITORING WELL: MW15-16

Project Number: 00206-2-2

Location: 208 Conway Street, Stewart, BC

Coordinates

Northing: 6199124.724

Easting: 438253.567

Datum: NAD83 - UTM Zone 9

Drilling Details

Drill Contractor: **Uniwide Drilling Co. Ltd.**

Drill Date: **October 18, 2015**

Drill Method: **Hollow Stem and Solid Stem Auger - Truck Mounted**

Depth of Drilled Hole (mbgs): **4.572**

Drillhole Diameter (inch): **9.25**

Well Installation Details


Final depth of well (mbgs): **2.521**

Well Casing Material: **PVC**

Well Screen Slot Size: **10 slot**

Well Casing Diameter (inch): **2**

Lithologic Description Depth (mbgs) Symbol	Soil Sampling Depth (ftbgs) Sample Type % Recovery Sample ID	Soil Sampling Sample Analyzed (Y,N)	Headspace Analysis		Elevation (masl)	Well Construction Details Construction Comments
			PPM	% LEL		

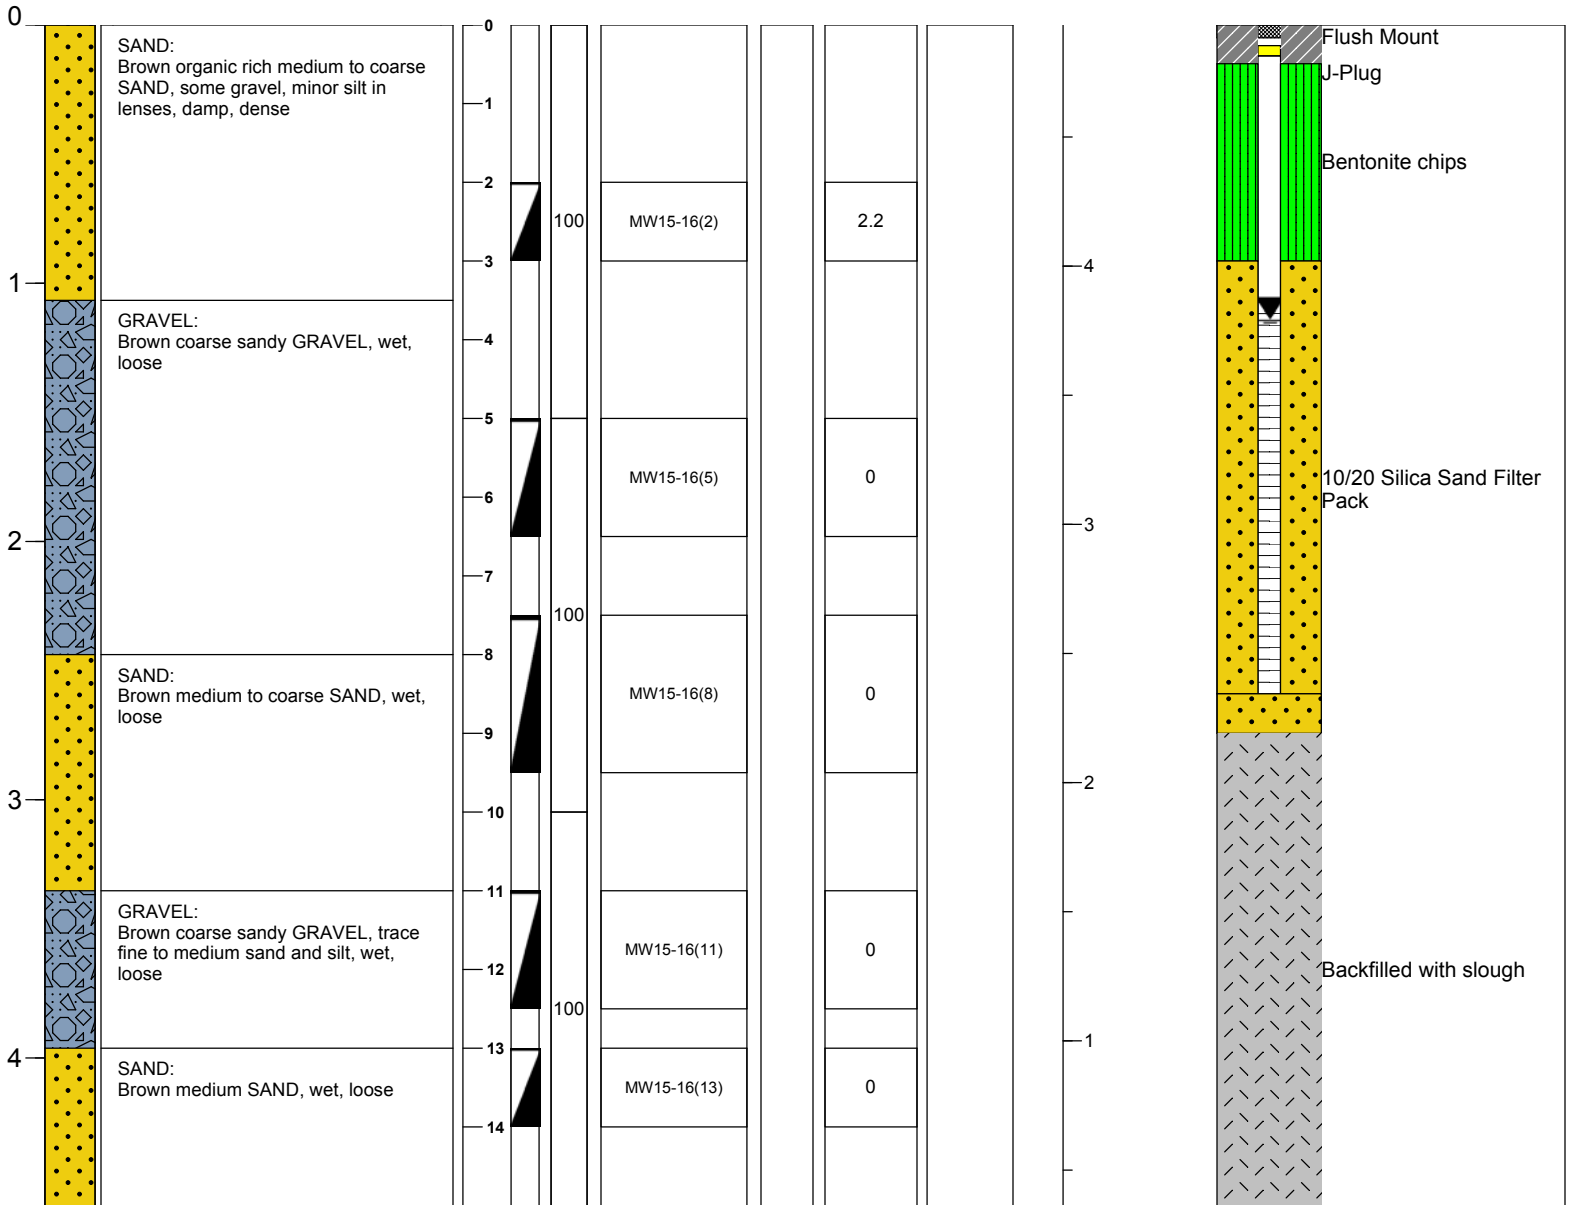

“For Environmental Purposes Only”



Report Date:

Logged by: **A.L.**

Approved by: **J.W.**

Client: **UCANCO General Partners Inc.**

Well Measurements

Depth to Water from TOC (m): **1.104**

Depth to Bottom from TOC (m): **2.515**

Well Elevation from TOC (masl): **4.934**

Ground Elevation (masl): **4.94**

Date Measured: **October 21, 2015**