



Client  
Shell Canada Products

Borehole No. : 12-33


Location  
106 Lower Ganges Rd., Saltspring Island, BC

PAGE 1 OF 1

Drilling Contractor: McRae's/Blue Max Environmental  
 Drilling Method: Hydrovac/Auger/Odex  
 Borehole Dia. (m): 0.15  
 Pipe/Slotted Pipe Dia. (m): 0.05/0.05

Date Monitored: 2012 11 22  
 Ground Surface Elev. (m): 3.770  
 Top of Casing Elev. (m): 3.660, 3.720  
 Northing: 503.840  
 Easting: 649.997

Project Number: 130364  
 Borehole Logged By: MBG/JWG  
 Date Drilled: 2012 11 02  
 Log Typed By: AS

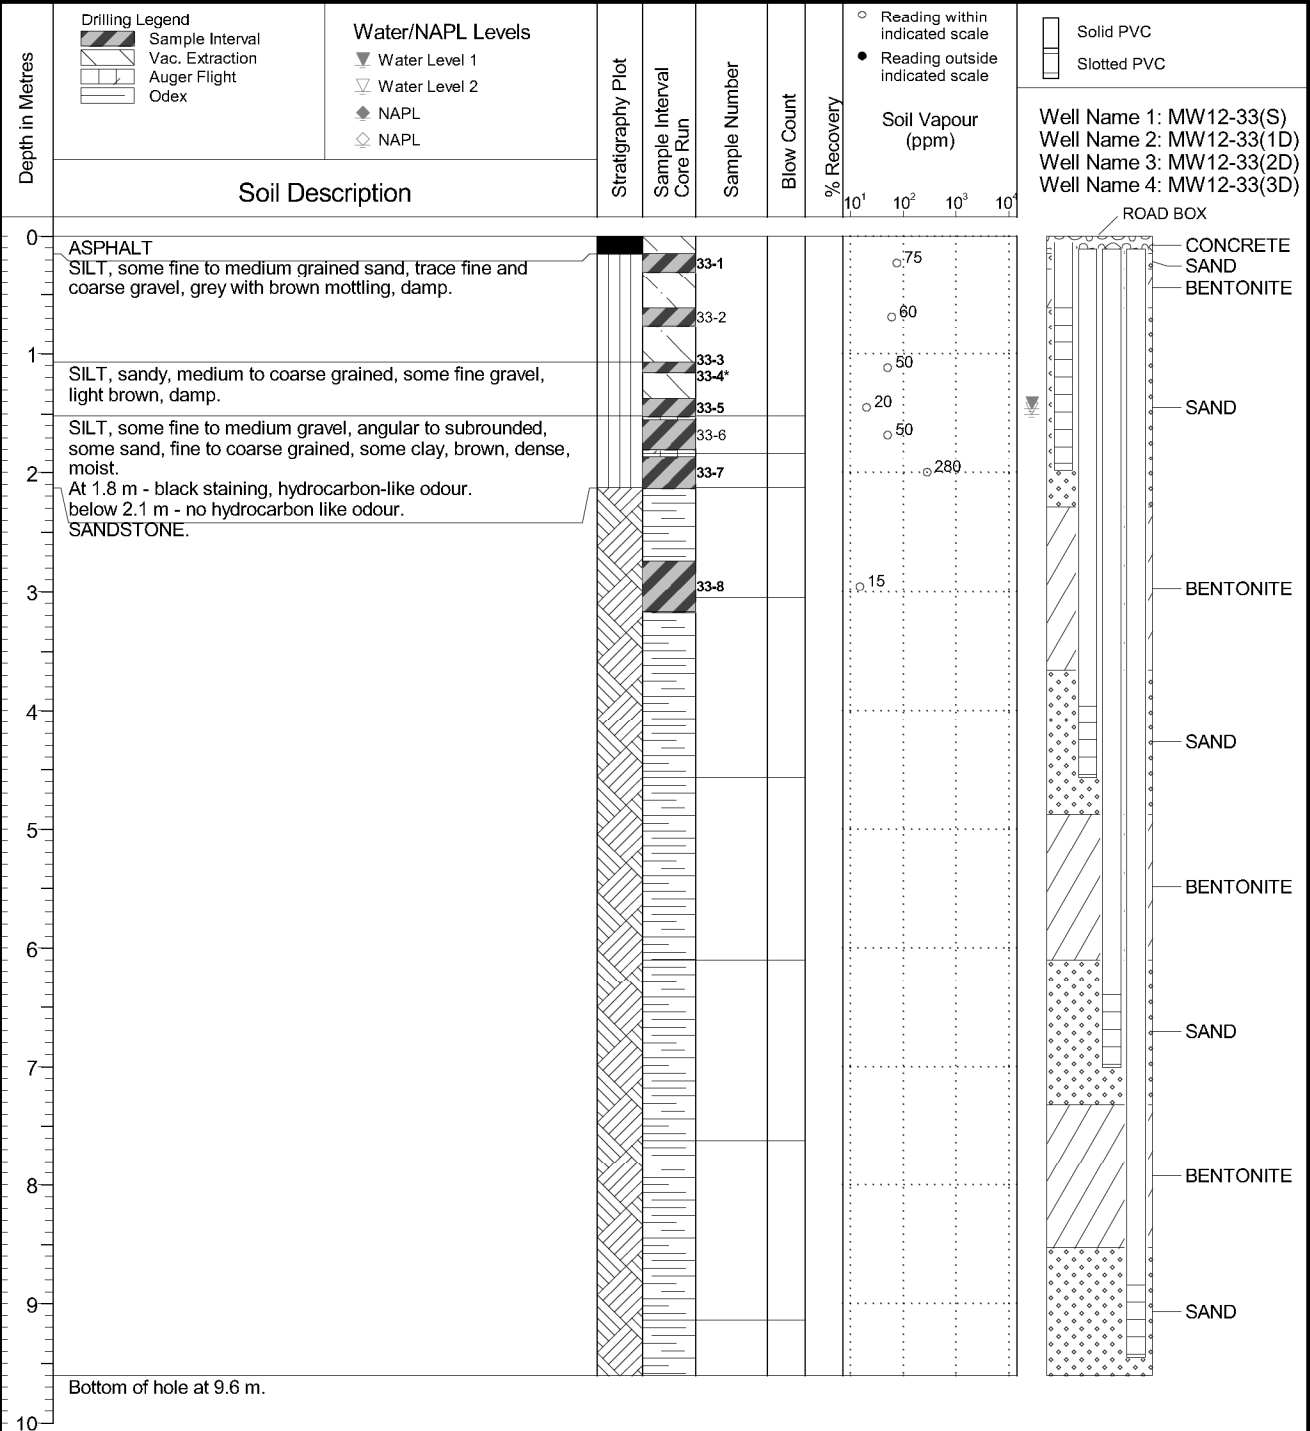

**NOTES**

Bolded sample denotes sample analyzed.  
 \* Sample 33-4 is a blind field duplicate of sample 33-3.

Print Date: 2015.04.15 QA1: JWG Date Approved: 2015.04.15

Any use which a third party makes of this document, or any reliance on or decisions to be made based on it, are the responsibility of such third parties. Shell Canada Products/SNC-Lavalin Inc./CSAP/MOE are not responsible for any use or modification of this document. Shell/SNC-Lavalin/CSAP/MOE accept no responsibility for damages, if any, suffered by any third party as a result of decisions made or actions taken based on this document.