


11650 & 11656 224th Street
 Maple Ridge, BC
 Project 1094

 Date Started : May 20, 2016
 Date Completed : May 20, 2016
 Hole Diameter : 152mm
 Drilling Method : Soild Stem/Hollow Stem
 Sampling Method : Grab

 Company Rep. : DM
 Lab Analysis : see below
 Drilled By : On-Track Drilling
 Logged By : DM

Depth in Meters	Surf. Elev.	USCS	GRAPHIC	DESCRIPTION	Sample No.	Soil Vapours ppm	Lab Analysis	Monitoring Well AE16-MW1		Soil Vapour Well AE16-SV1	
0				SILT and SAND, brown, soft, moist	1-1	-	*				
1		SM		SILT and CLAY, brown, firm, moist	1-2	-	*				
2				SILTY CLAY, brown	1-3	-	*				
3											
4				grey, soft	1-4	-					
5											
6				End of Hole	1-5	-					
7											

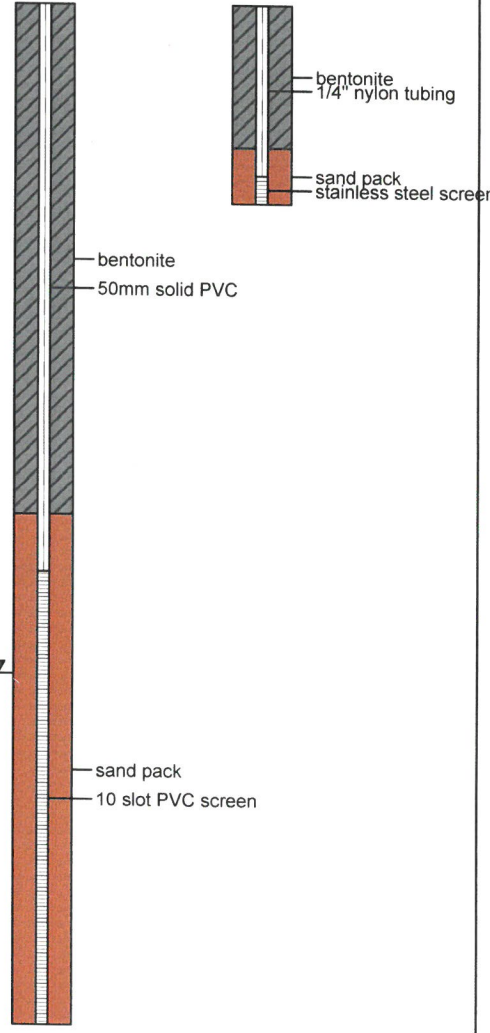

Any use which a third party makes of this document, or any reliance on or decisions to be made based on it, are the responsibility of such third parties. CSAP/MOE are not responsible for any use or modification of this document. CSAP/MOE accept no responsibility for damages, if any, suffered by any third party as a result of decisions made or actions taken based on this document.