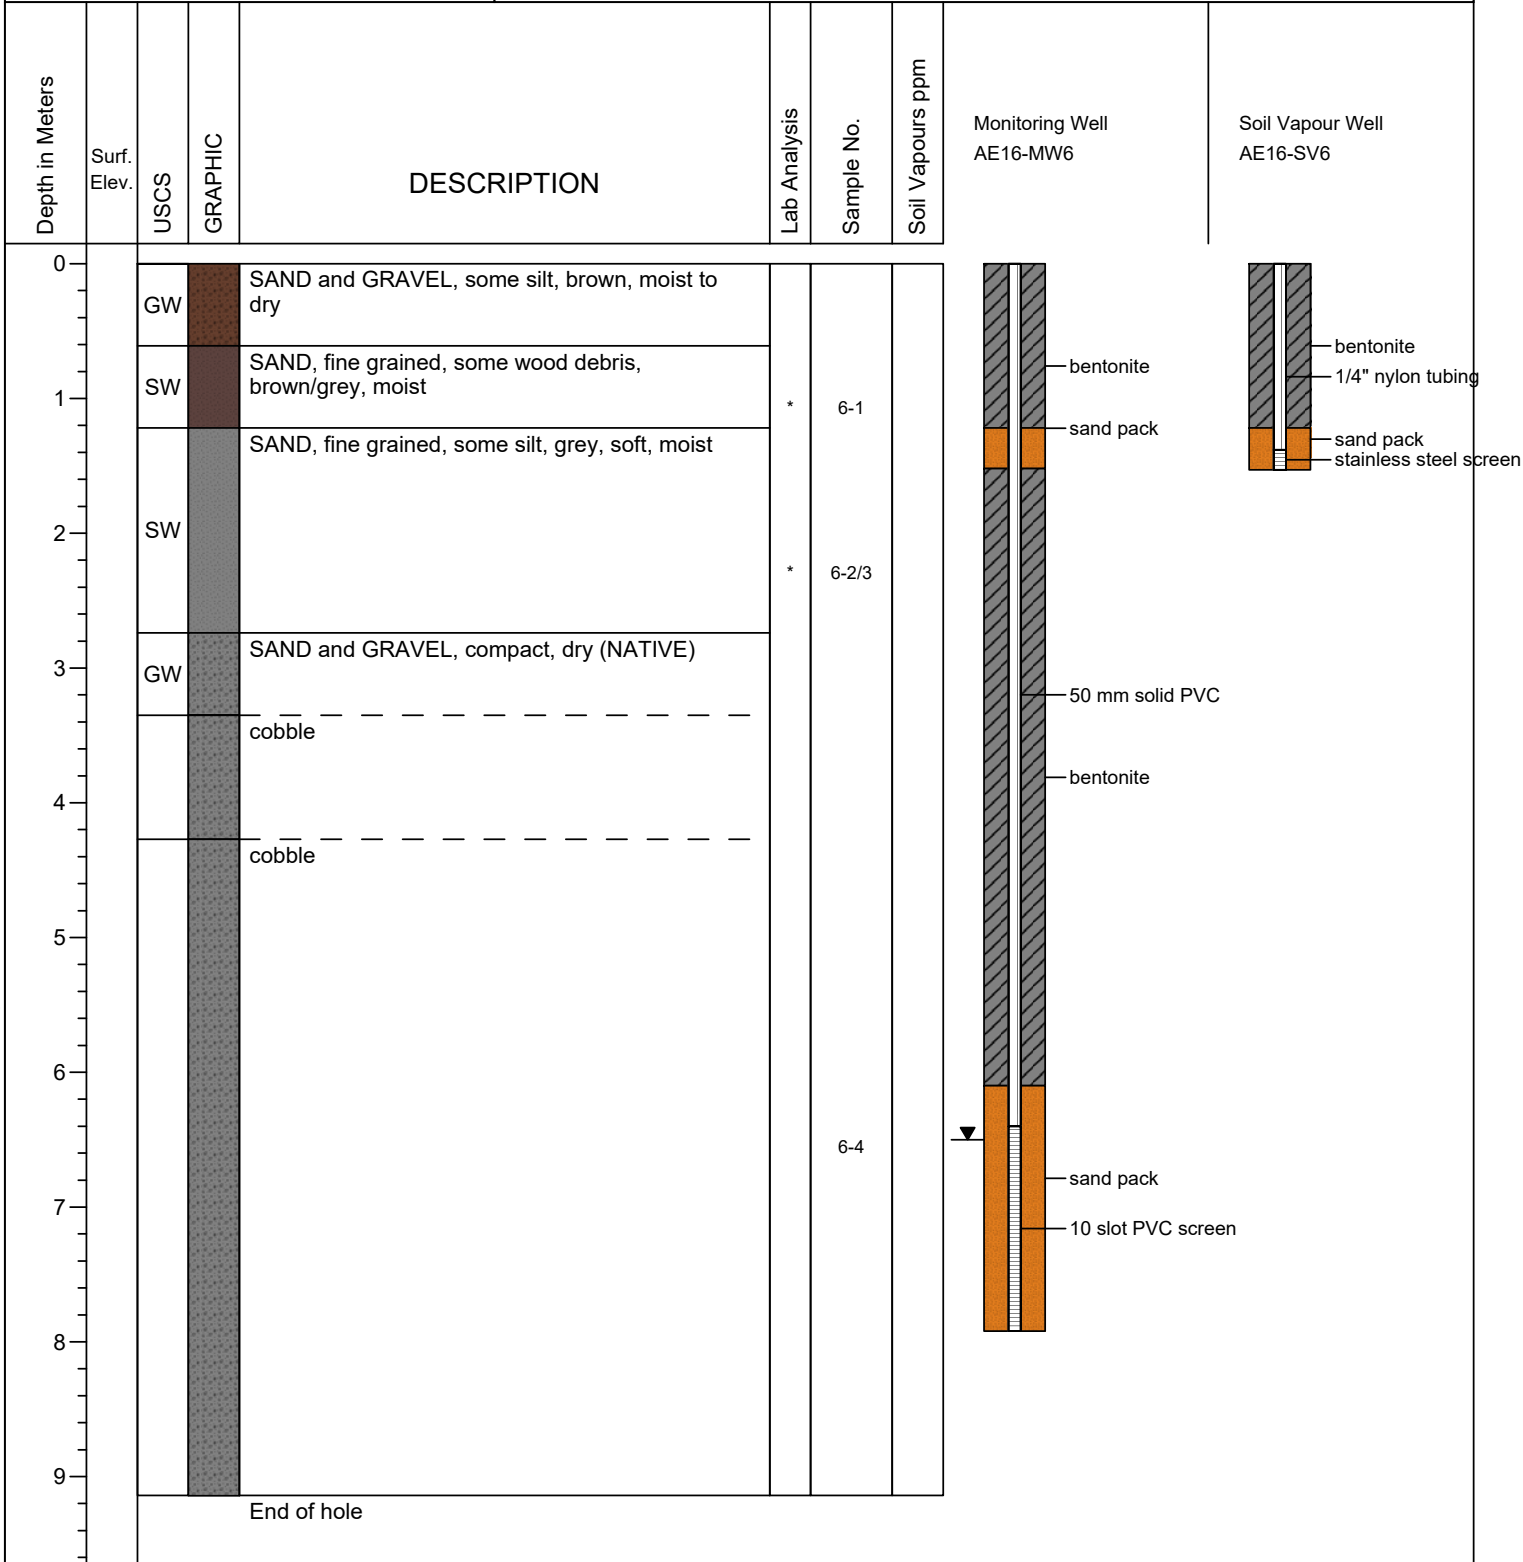


3111 Kenney Ave, 5014 & 5020 Keith Ave  
 Terrace, BC  
 Project 1105

 Date Started : April 20, 2016  
 Date Completed : April 20, 2016  
 Hole Diameter : 152mm  
 Drilling Method : Odex  
 Sampling Method : Grab

 Company Rep. : BR  
 Lab Analysis : \*indicates sent for analysis  
 Drilled By : Blue Max  
 Logged By : BR


2016 C:\Users\Admin\Dropbox (Active Earth)\Enviro Projects\1105 - Kenney and Keith Terrace\AE Investigation\Logs\16MW-m.bor