

Project No.: MOR6102

Location: 30697 & 30709 Keystone Ave. Mission, BC

Client: 1030294 BC LTD.


APEC: SEPTIC AREA

Logged By: JC

Borehole No.: BH17-01



SUBSURFACE PROFILE				SAMPLE			HV Concentration ppm 125 250 375 %LEL 20 40 60 80	Well Completion Details
Depth	Symbol	Description	Elev.	Number	Type	Recovery		
ft m								
0		Ground Surface						
1		SAND, silty, trace gravel, reddish-brown, trace organics, moist.						
2		SAND, trace gravel, reddish-brown, moist.		1-1	☒	1.1		
3		SAND & GRAVEL, grey/brown, moist.						
4		SAND & GRAVEL, grey/brown, moist.		1-2	☒	1.5		
5		- Auger refusal at 6'.						
6		End of Borehole						
7								
8								
9								
10								
11								
12								
13								
14								

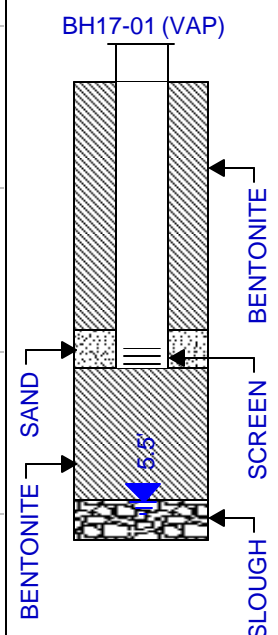

"FOR ENVIRONMENTAL PURPOSES ONLY"

Drill Method: SOLID STEM AUGER

Sample Type: GRAB

Hole Size: 6"

Drilled By: BLUE MAX DRILLING

Top of Casing Elev. (m): N/A

Surface Elev. (m): N/A

Drill Date: MAY 8, 2017

Water Level Measured: ~1.7 m

Checked By: JC

Sheet: 1 of 1