





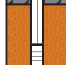

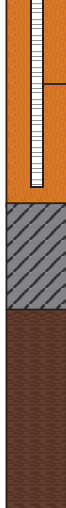

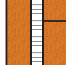










3681 Victoria Drive
 Vancouver, BC

AE Project No. 681

 Date Started : April 17, 2014
 Date Completed : April 17, 2014
 Hole Diameter : 127 mm
 Drilling Method : Solid Stem Auger
 Sampling Method : Grab

 Company Rep. : SB
 Lab Analysis : *indicates sent for analysis
 Drilled By : Uniwide
 Logged By : SB

Depth in Meters	Surf. Elev.	USCS	GRAPHIC	DESCRIPTION	Lab Analysis	Sample No.	Soil Vapours ppm	Monitoring Well AE14-MW4
0		AR		ASPHALT				
		SM		SILT and SAND				
1				TILL weathered, orange/tan				
2		GW			*	4-1	0	
				TILL, grey, dense				
3								
4		GW						
5								
6								
				SILTSTONE				
7		SS						
8				End of Hole				
9								
10								

Any use which a third party makes of this document, or any reliance on or decisions to be made based on it, are the responsibility of such third parties. CSAP/MOE are not responsible for any use or modification of this document. CSAP/MOE accept no responsibility for damages, if any, suffered by any third party as a result of decisions made or actions taken based on this document.