



Client
Ministry of Transportation and Infrastructure

Borehole No. : BH16-03


Location
Errington Pit

PAGE 1 OF 1

Drilling Contractor Blue Max Environmental
Drilling Method Solid Flyte Auger
Borehole Dia. (m) 0.20
Pipe/Slotted Pipe Dia. (m) 0.05/0.05

Date Monitored 2016 10 24
Ground Surface Elev. (m) 97.631
Top of Casing Elev. (m) 98.400
Northing: 5462491.780 Easting: 400931.620

Project Number: 511364
Borehole Logged By: CT
Date Drilled: 2016 10 20
Log Typed By: SGP

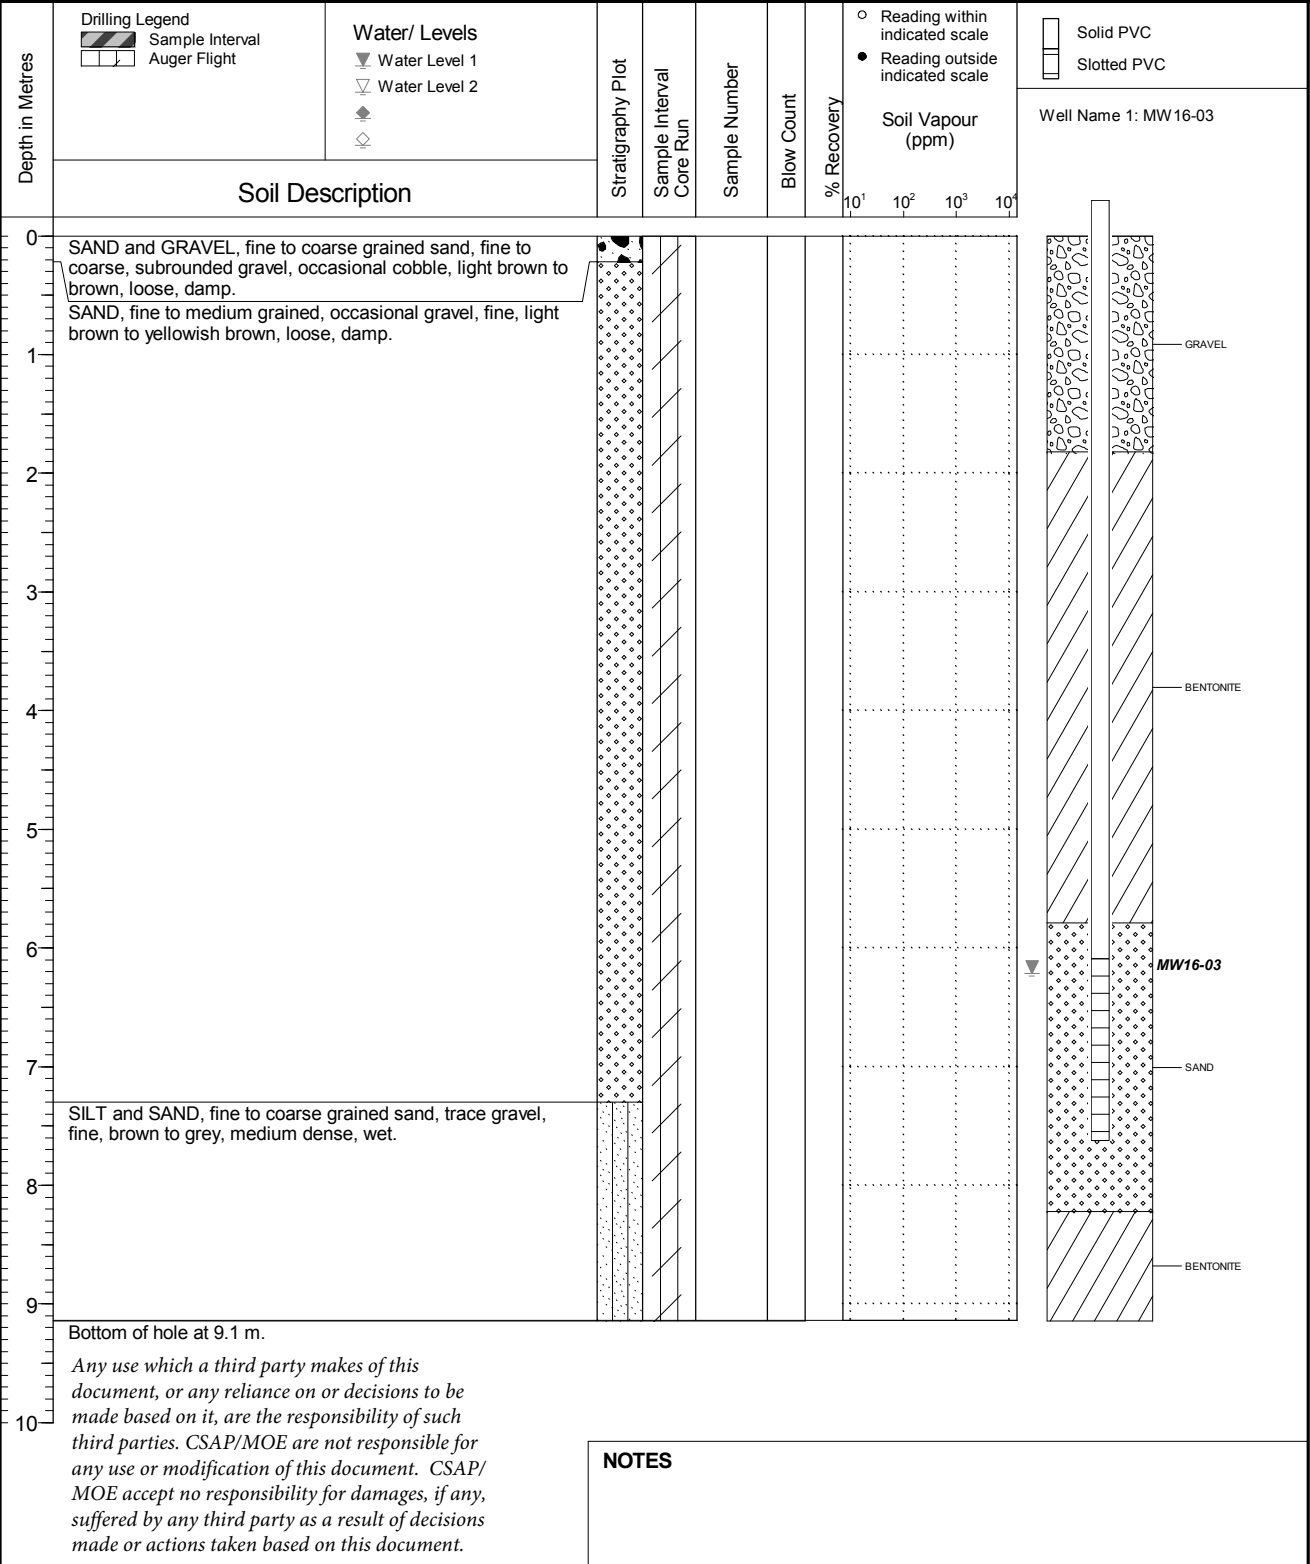

Any use which a third party makes of this document, or any reliance on or decisions to be made based on it, are the responsibility of such third parties. CSAP/MOE are not responsible for any use or modification of this document. CSAP/MOE accept no responsibility for damages, if any, suffered by any third party as a result of decisions made or actions taken based on this document.

NOTES

QA-DG 2016 11 08 Print Date: 2017-01-25