Log of Monitoring Well: MW15-02

HEMMERA

Project Name/No: 285-103.02

Client: Ministry of Transportation & Infrastructure

Date Drilled: November 16 & 20, 2015

Site Location: 300 Comox, Nanaimo

Drilling Company: H2X, Drillwell

Drilling Method: Hydrovac, Sonic

Logged by: JE/GR

Sheet: 1 of 1

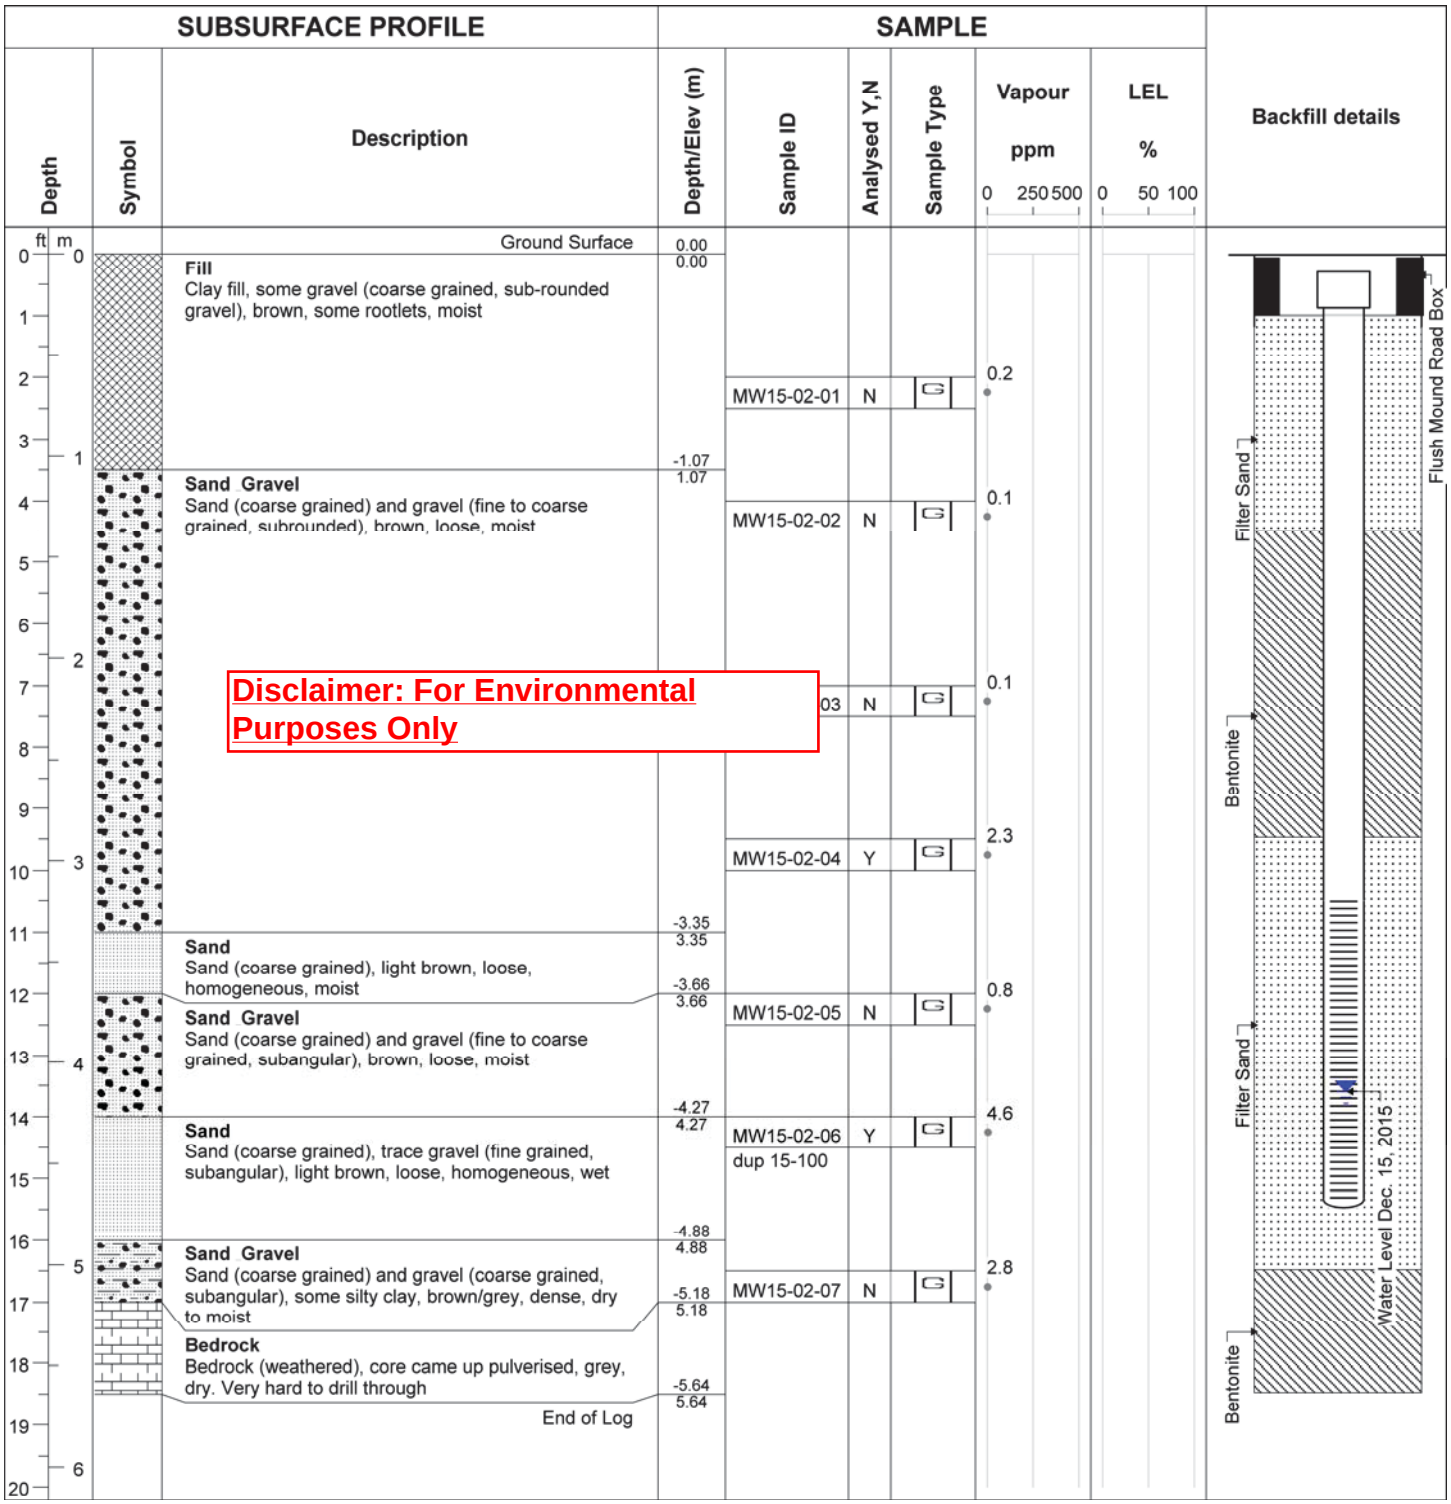

Well location: MW15-02

Depth to water level (TOC): 4.15 m

Date of water level: December 15, 2015

Borehole diameter: 6"

Well casing diameter: 5 cm

Well casing material: PVC

Well screen slot size: 0.025 cm

Well screen interval (bgs): 3.2 - 4.7 m

Depth of well (TOC): 4.75 m

Well Elevation (TOC): 16.76 m asl

Ground Elevation: 16.86 m asl