



Client  
Shell Canada Products

Borehole No. : 14-39


Location  
4404 - 50th Avenue, Fort Nelson, BC

PAGE 1 OF 1

Drilling Contractor Troyer Ventures  
Drilling Method Hollow Stem Auger/Hydrovac  
Borehole Dia. (m) 0.20  
Pipe/Slotted Pipe Dia. (m) 0.05/0.05

Date Monitored n/a  
Ground Surface Elev. (m) 98.868  
Top of Casing Elev. (m) 98.795  
Northing: n/a Easting: n/a

Project Number: 134046  
Borehole Logged By: YFW  
Date Drilled: 2014 05 22  
Log Typed By: CD

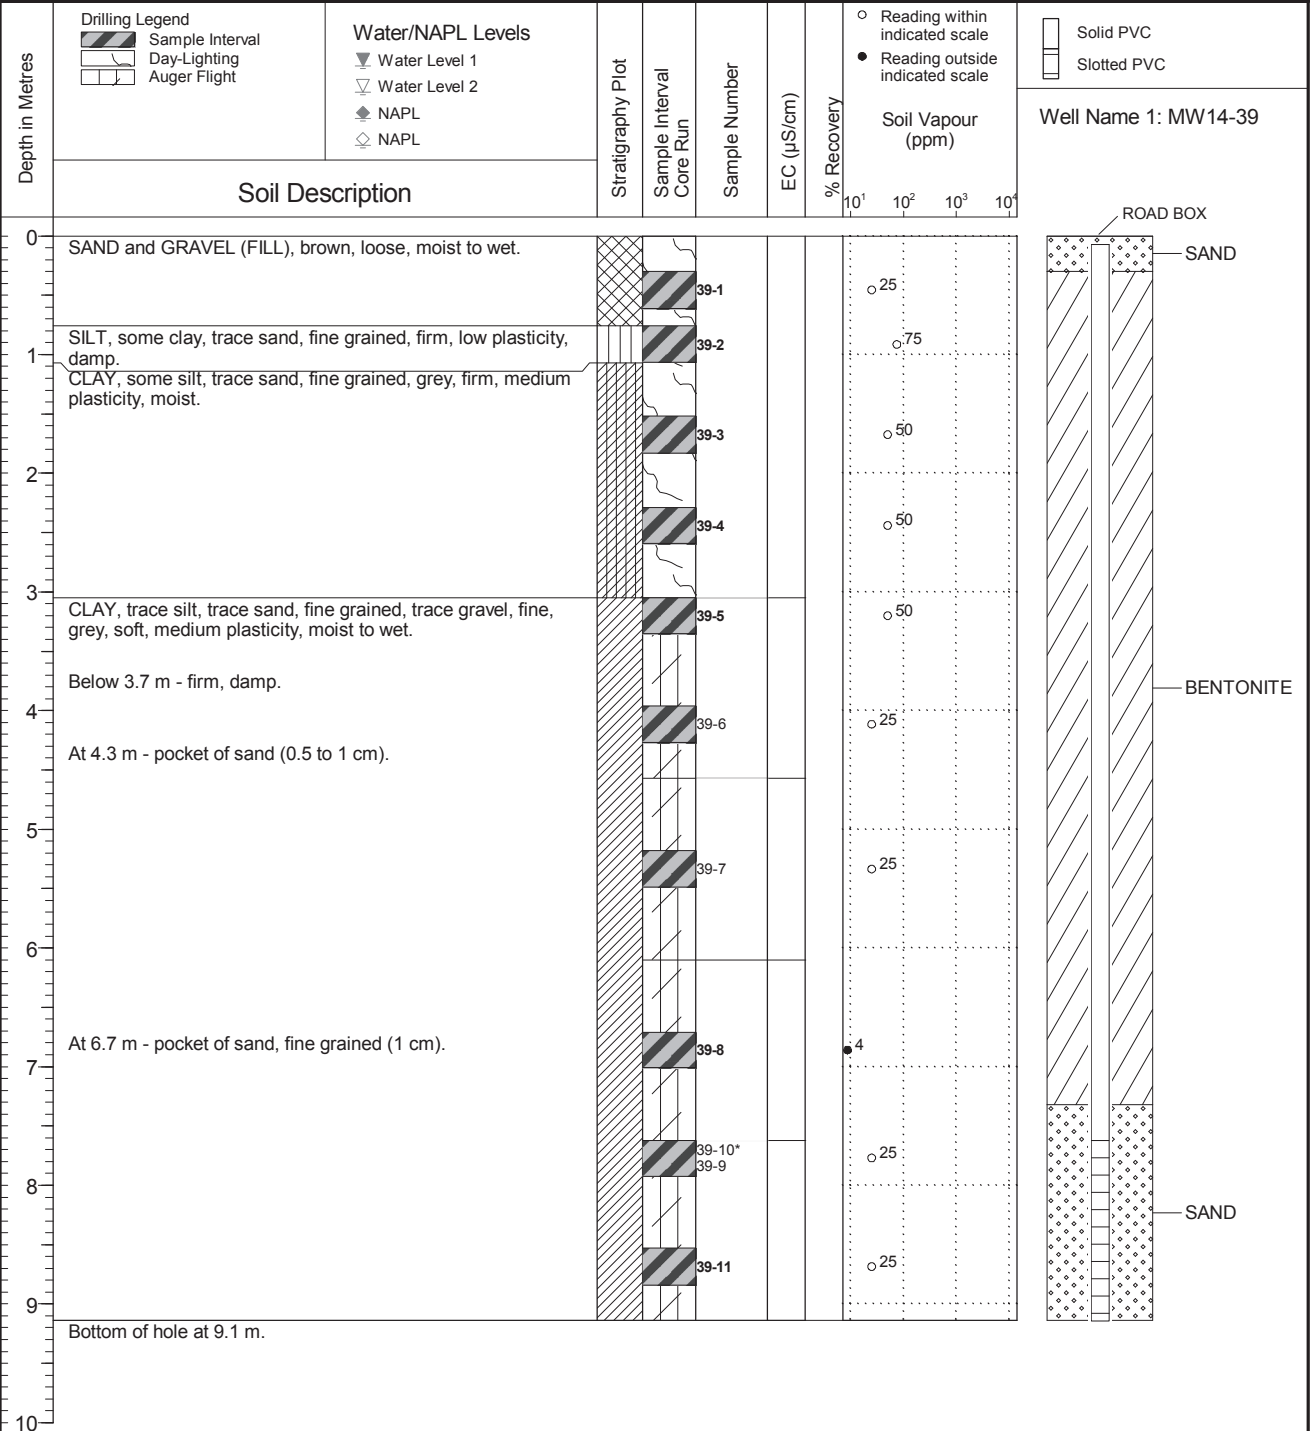

**NOTES**  
 Bolded sample denotes sample analyzed.  
 \*Sample 39-10 is a blind field duplicate of 39-9.

Print Date: 2015-10-05 Date Approved: 2014-05-28