



SNC-LAVALIN
Environment

Client :
Shell Canada Products

Borehole No. : 11-29


Location :
1305 Marine Drive, West Vancouver, BC

(Page 1 of 1)

Drilling Contractor: McRae's Environmental/Uniwide Drilling
Drilling Method : Hydrovac/Solid Stem Auger
Borehole Dia. (m) : 0.15
Pipe/Slotted Pipe Dia. (m): 0.05, 0.05

Date Monitored : 2012 01 09
Top of Casing Elev. (m) : 13.834
Northing: 82885.5345 Easting: 49339.4717

Project Number :130404
Borehole Logged By :ST
Date Drilled :2011 12 07
Log Typed By :OM

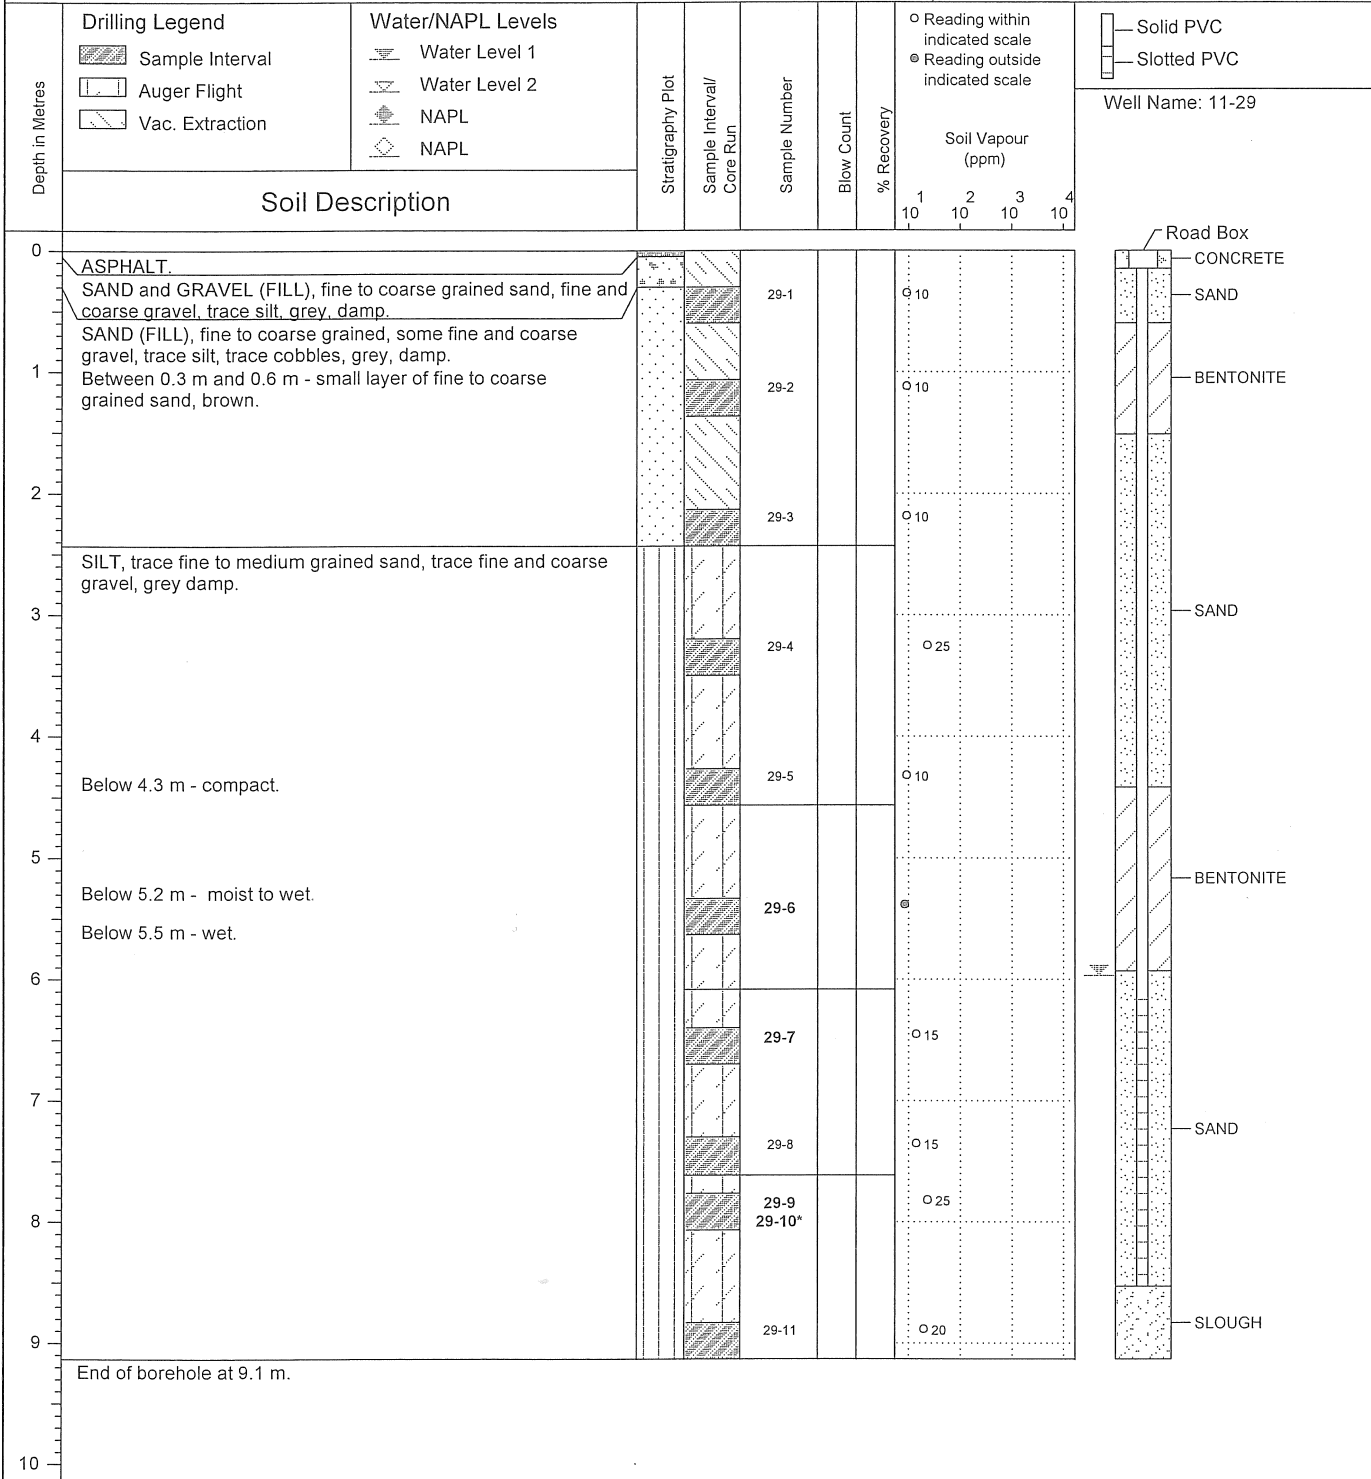

Notes:
 Bolded sample denotes sample analyzed.
 * denotes blind field duplicate.
 29-10 is a blind field duplicate of 29-9.

Print Date: 2012 09 19, Date Approved: 2012 01 13