


Drilling Contractor Beck Drilling and Environmental Serv  
Drilling Method Hydrovac/Hollow Stem Auger  
Borehole Dia. (m) 0.25  
Pipe/Slotted Pipe Dia. (m) 0.05/0.05

Date Monitored 2011 08 02  
Ground Surface Elev. (m) 65.210  
Top of Casing Elev. (m) 65.140 65.160  
Northing: 5367550.060 Easting: 462374.870

Project Number: 504604  
Borehole Logged By: MMJ/JAR/PKS  
Date Drilled: 2011 07 27  
Log Typed By: MAL

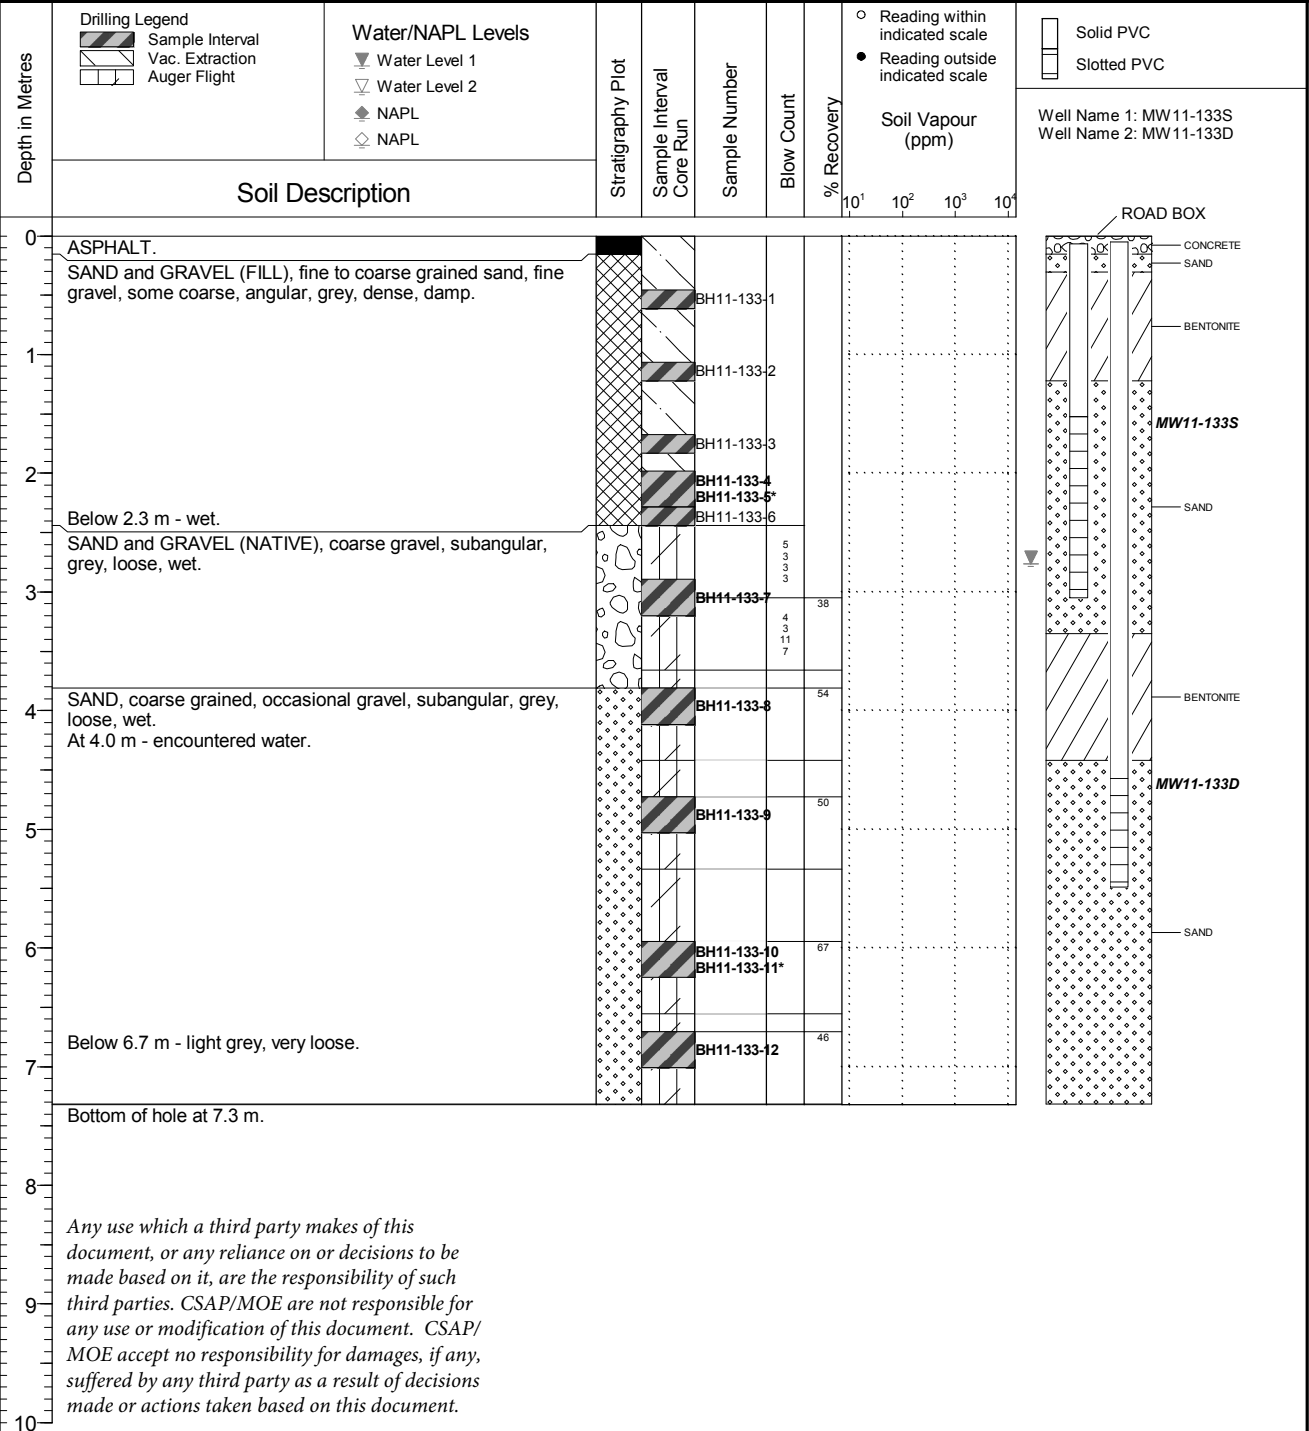

Any use which a third party makes of this document, or any reliance on or decisions to be made based on it, are the responsibility of such third parties. CSAP/MOE are not responsible for any use or modification of this document. CSAP/MOE accept no responsibility for damages, if any, suffered by any third party as a result of decisions made or actions taken based on this document.

**NOTES**  
 Bolded sample denotes sample analyzed.  
 \*Sample BH11-133-5 is a blind field duplicate of BH11-133-4.  
 \*Sample BH11-133-11 is a blind field duplicate of BH11-133-10.  
 Borehole day-lighted to a depth of 2.4 m on 2011 07 27.