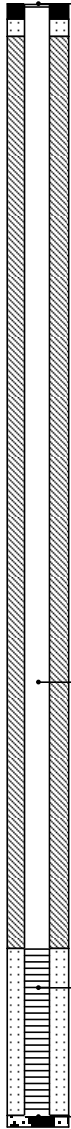


Log of Borehole: 17-BH102

For Environmental Purposes Only

Location: 349 West Georgia Street, Vancouver, British Columbia

SUBSURFACE PROFILE				SAMPLE			Well Completion Details
Symbol	Depth	Description	Depth (m)	Sample Name	Sample Type	Vapour (ppm)	
	0	Ground Surface	0.00				 <p>0-0.15 m Well casing in concrete. 0.15-0.3 m Solid PVC pipe in silica sand.</p> <p>0.3-8.5 m Solid PVC pipe in bentonite seal.</p> <p>8.5-10.0 m Slotted PVC pipe in silica sand.</p> <p>10.0-10.1 m Slough.</p>
	2	Grey, CONCRETE, minor staining from parked cars.		0.3	Grab	1.3	
	4	Grey, GRAVEL AND COBBLES, no odours, no staining.		0.8	Grab	0.9	
	6	Grey, SILTY SAND, dry, no odours, no staining.		1.6	Grab	0.6	
	8			2.5	Grab	2.0	
	10			3.0	Grab	1.9	
	12			4.0	ODEX	1.6	
	14			5.2	ODEX	0.1	
	16						
	18						
	20						
	22	Groundwater Monitoring Well is dry.		7.0	ODEX	0.1	
	24			7.5	ODEX	2.3	
	26			8.0	ODEX	1.3	
	28			9.0	ODEX	2.1	
	30			10.0	ODEX	0.8	
	32						
	34	End of Borehole	10.10				

Drill Method: Solid Stem Auger and ODEX

Drill Date: 5/10/2017