



SNC-LAVALIN
Environment

Client:
Shell Canada Products

Borehole No. : BH03-7


Location :
3480 Skaha Lake Road, Penticton, BC

(Page 1 of 2)

Drilling Contractor: Geotech Drilling Services Ltd.
Drilling Method : Hollow Stem Auger
Borehole Dia. (m) : 0.20
Pipe/Slotted Pipe Dia. (m): 0.05, 0.05

Ground Surf Elev. (m) : 340.01
Top of Casing Elev. (m) : 339.91

Project Number : 131004
Borehole Logged By : DJK
Date Drilled : 2003 07 21
Log Typed By : SW

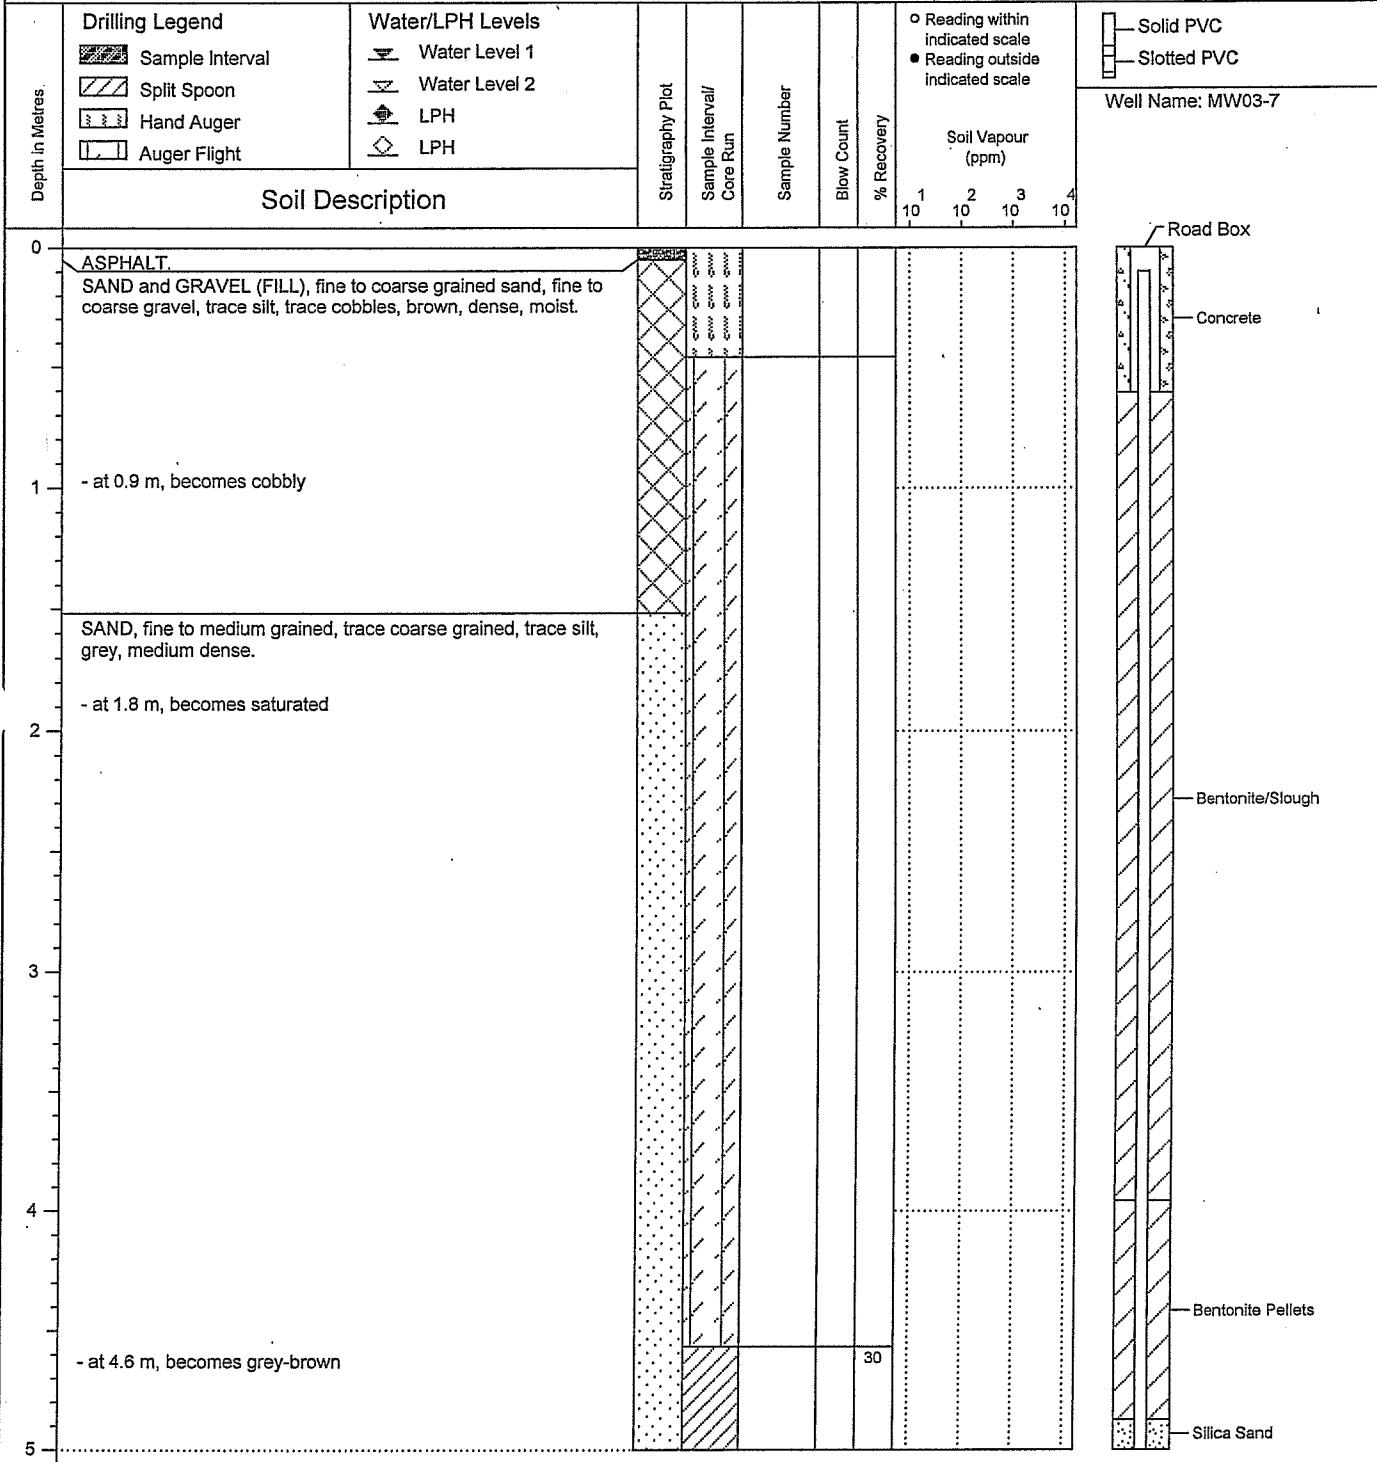

Notes:

file: 2009 09 24, Date Approved: 2004 04 02



MORROW

FOCUSED ON SOLUTIONS

Client :
Shell Canada Products

Borehole No. : BH03-7


Location :
3480 Skaha Lake Road, Penticton, BC

(Page 2 of 2)

Drilling Contractor: Geotech Drilling Services Ltd
Drilling Method : Hollow Stem Auger
Borehole Dia. (m) : 0.20
Pipe/Slotted Pipe Dia. (m): 0.05, 0.05

Ground Surf Elev. (m) : 340.01
Top of Casing Elev. (m) : 339.91

Project Number : V9250
Borehole Logged By : DJK
Date Drilled : 2003 07 21
Log Typed By : SW

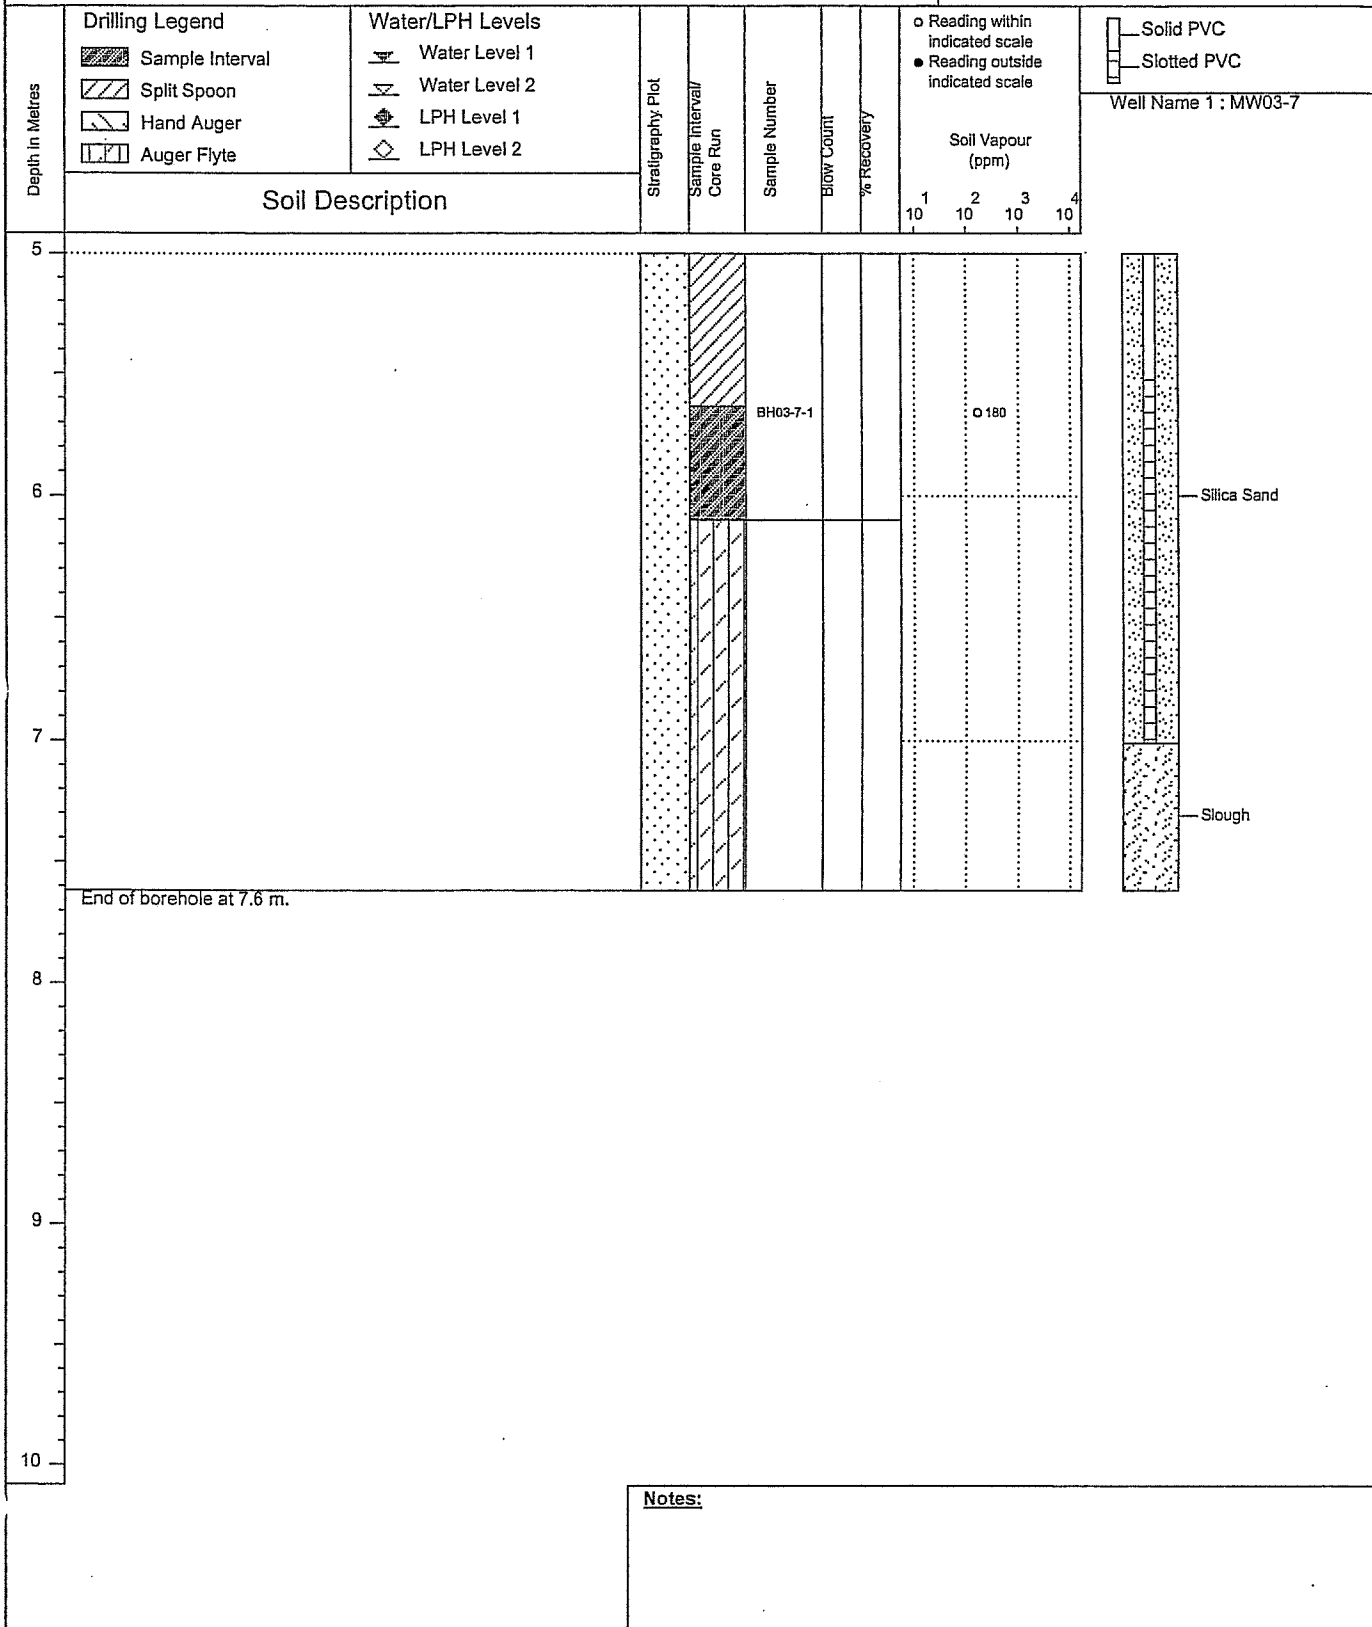

Notes: