



**SNC-LAVALIN**  
**Morrow Environmental**

Client :  
Shell Canada Products

**Borehole No. : 00-6**

Location :  
990 Ellis St., Kelowna



(Page 1 of 1)

Drilling Contractor: Uniwide Drilling Co. Ltd.  
Drilling Method : Solid Stem Auger  
Borehole Dia. (m) : 0.15  
Pipe/Slotted Pipe Dia. (m): 0.05, 0.05

Date Monitored : 2000 08 02  
Ground Surf Elev. (m) : 344.243  
Top of Casing Elev. (m) : 344.57

Project Number : 130374  
Borehole Logged By : PJT  
Date Drilled : 2000 08 01  
Log Typed By : AS

Depth in Metres	Drilling Legend	Water/LPH Levels Water Level 1 Water Level 2 LPH LPH	Stereolithography Plot	Sample Interval/ Core Run	Sample Number	Blow Count	% Recovery	Soil Vapour (ppm)				Well Name: 00-6
								1	2	3	4	
0	SAND and GRAVEL (FILL), cobbly, fine to medium grained sand, fine to coarse gravel, light brown, loose, damp.											
1	SAND, medium grained, light brown, loose, damp.											
	- at 1.5 m, becomes medium to coarse grained, grey, wet											
	- at 1.8 m, becomes saturated											
2												
3												
4	SAND, fine grained, silty, medium grey, some brown mottling, saturated.											
End of borehole at 4.6 m.												
5												

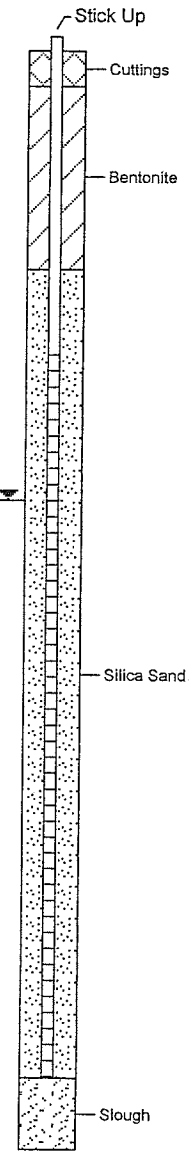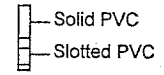

**Notes:**  
No soil samples were collected.

Print Date: 2006 12 13, Date Approved: 2006 12 13