


PROJECT: ENVIRONMENTAL ASSESSMENT	CLIENT: HAWKEYE HOLDINGS LTD.	BOREHOLE NO: 95-88155BH1
LOCATION: 3396 SEXSMITH ROAD	CONTRACTOR: SANDWELL GEOLOGICAL DRILLING	PROJECT NO: 0808-95-88155
KELOWNA, B.C.	RIG: MODIFIED B61, SOLID AUGER	ELEVATION:
SAMPLE TYPE	<input checked="" type="checkbox"/> GRAB <input type="checkbox"/> <input checked="" type="checkbox"/> SPT SPLIT SPOON <input type="checkbox"/> <input type="checkbox"/>	

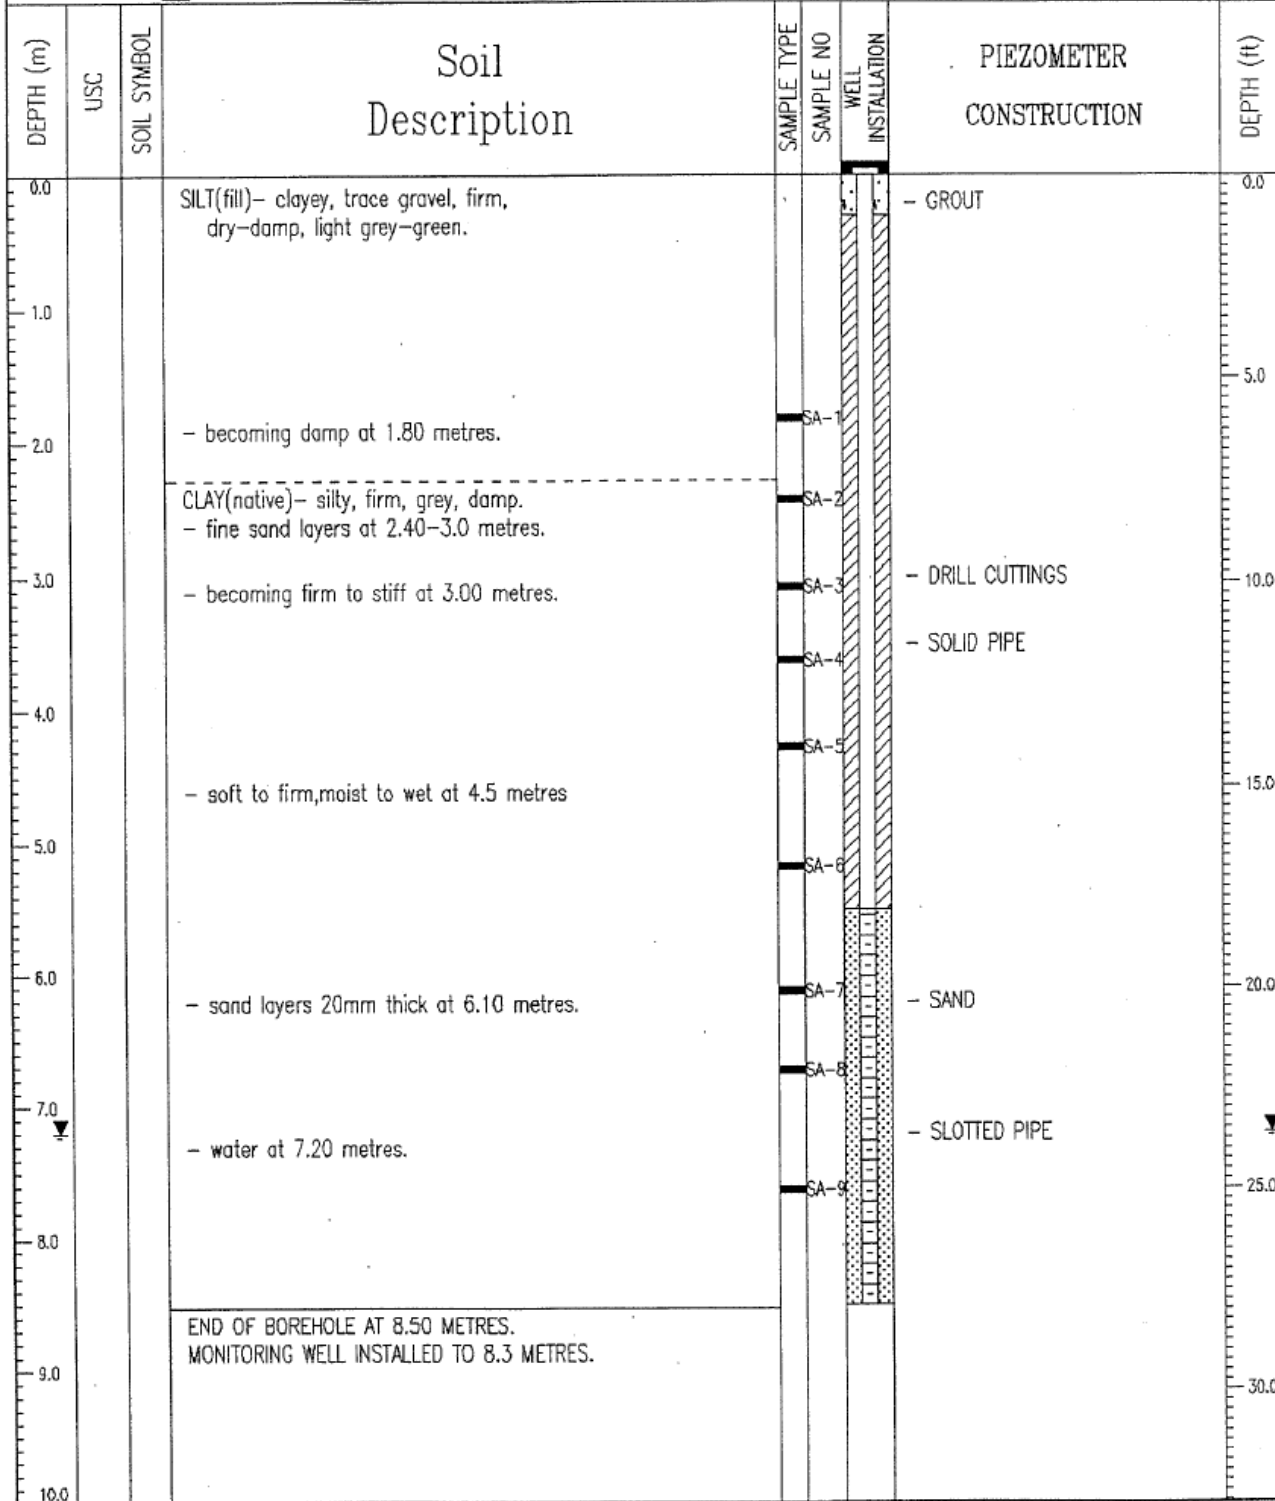

EBA Engineering Consultants Ltd. Kelowna, B.C.	LOGGED BY: RLD	COMPLETION DEPTH: 8.5 m
	REVIEWED BY: TRM	COMPLETE: 95/06/27
	Fig. No: 95-88155-1	Page 1 of 1