


RW10

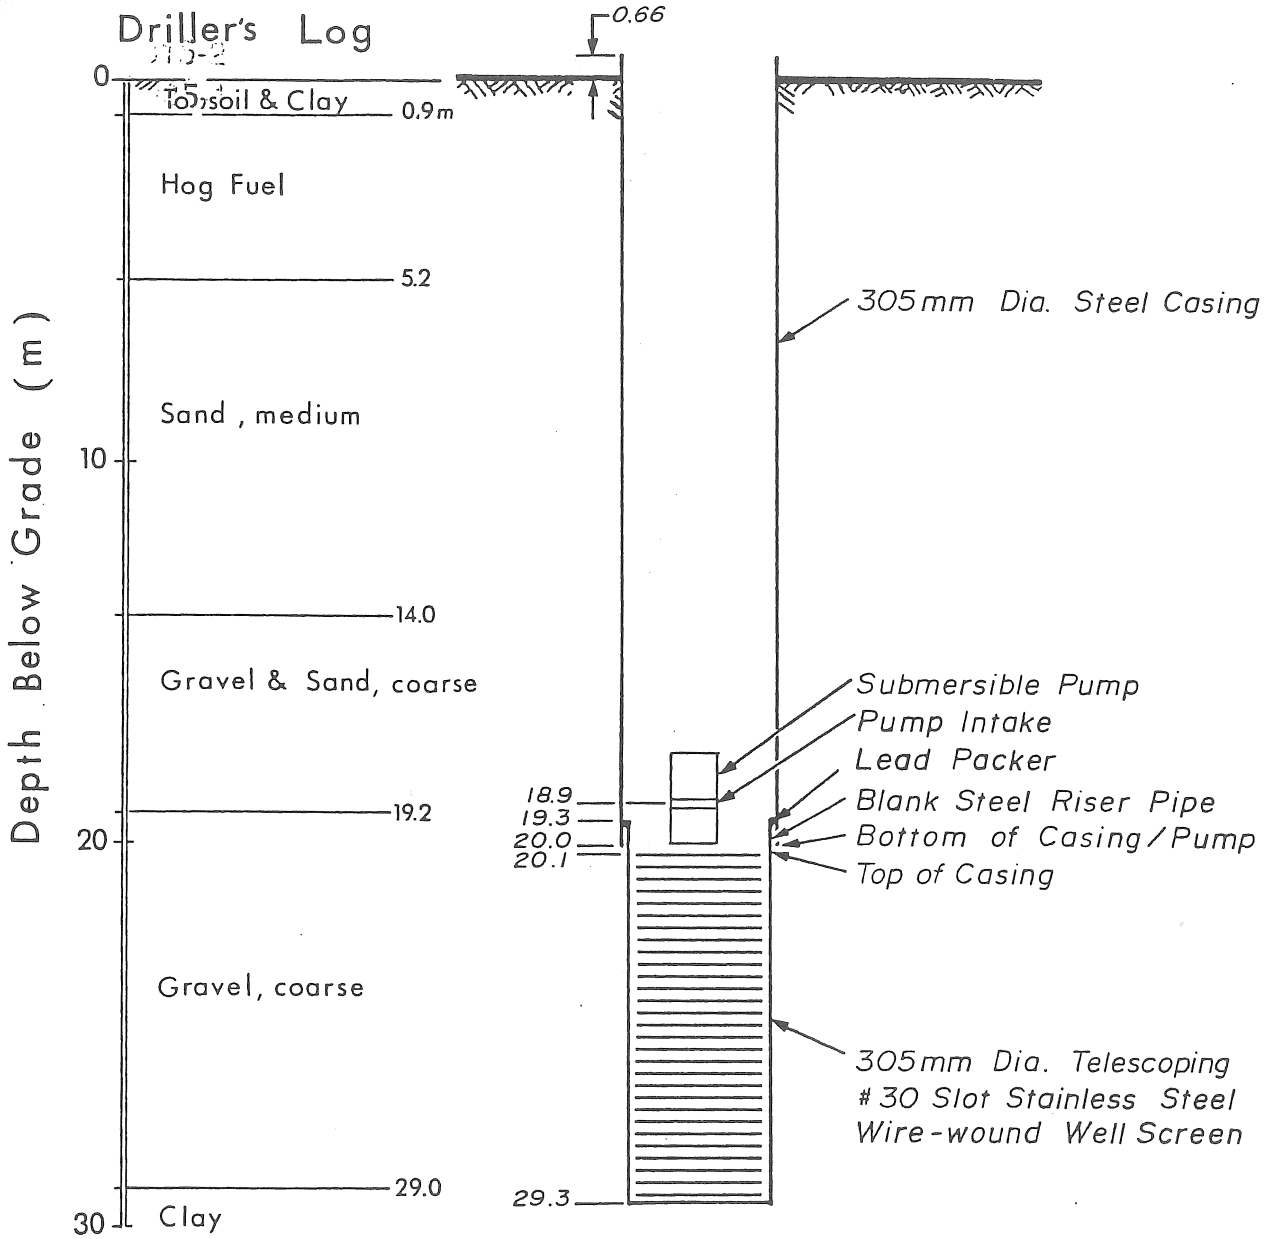

Not to Scale

Well Construction and Pump Installation
 Details RW10

O'CONNOR ASSOCIATES

JOB NO. : 10-373.7

DATE : 87/09/18

DRAWN BY : DE

DWG. NO. : 1.3