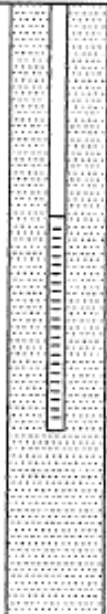



CLIENT: SHELL CANADA PRODUCTS LTD.	DRILLING CONTRACTOR: MUD BAY	PROJECT No.: V4-247
LOCATION: 4419-27th., VERNON, B.C.	DRILLING METHOD: GEOPROBE	DIAMETER: 25 mm
		BOREHOLE No.: 95-10

SAMPLE TYPE: CORE SPLIT SPOON SHELBY DISTURBED NO RECOVERY

ELEV. - DEPTH (m)	SOIL DESCRIPTION	STRATIGRAPHY PLOT	SAMPLE TYPE	SAMPLE NUMBER	SOIL VAPOUR CONCENTRATION (ppm)				WATER LEVEL	MONITORING WELL INSTALLATION
					10	100	1000	10000		
0	Brown, medium SAND, some silt, trace medium gravel									
1	Brown SAND, some silt, trace gravel, wet grades to medium/coarse sand, some gravel	CORE 4		S4			▲ 20			
2	Interbedded SAND and SILT	CORE 5		S5			▲ 36			
3	Brown medium SAND	CORE 6		S6			▲ 10			
4	Grey brown SILT, some sand									
	End borehole at 4.3m below grade									
5										
6										
7										
8										
9										

LEGEND

-  25 mm PVC pipe
-  25 mm slotted PVC pipe
-  silico sand backfill

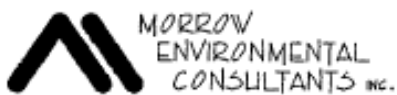

GROUND SURFACE ELEVATION (m):
N/A

TOP OF CASING ELEVATION (m):
N/A

DATE DRILLED:
95 07 05

LOGGED BY:
N.S.