



Client :
Petro Canada Refinery

Borehole No. : 02-41

Location :
Former Taylor Refinery, Taylor, BC


(Page 1 of 1)

Drilling Contractor: Cariboo
Drilling Method : Air Rotary
Borehole Dia. (m) : 0.15
Pipe/Slotted Pipe Dia. (m): 0.05, 0.05

Date Monitored : 2002 09 30
Ground Surf Elev. (m) : 469.9
Top of Casing Elev. (m) : 469.689

Project Number : V7202
Borehole Logged By : TAB
Date Drilled : 2002 07 13
Log Typed By : MVW

Depth in Metres	Drilling Legend ☐ Vac. Extraction	Water/LPH Levels ▽ Water Level 1 ▽ Water Level 2 ◆ LPH ◇ LPH	Stratigraphy Plot	Sample Interval/ Core Run	Sample Number	Blow Count	% Recovery	Soil Vapour (ppm)				Well Name: 02-41
								1	2	3	4	
0												
1												
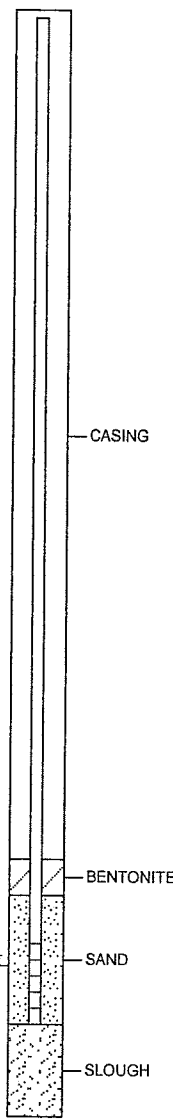

Notes:

Print Date: 2004 10 15, Date Updated: 2004 10 15