



Client  
Imperial Oil

Borehole No. : 13-22D


Location  
4472 E. Hastings, Burnaby, BC

PAGE 1 OF 1

Drilling Contractor Badger Daylighting/Mud Bay Drilling  
Drilling Method Hydrovac/Vibratory Sonic  
Borehole Dia. (m) 0.20  
Pipe/Slotted Pipe Dia. (m) 0.05/0.05

Date Monitored n/a  
Ground Surface Elev. (m) n/a  
Top of Casing Elev. (m) n/a  
Northing: 115.300 Easting: 61.306

Project Number: 507085  
Borehole Logged By: SJB  
Date Drilled: 2013 07 03  
Log Typed By: SGP

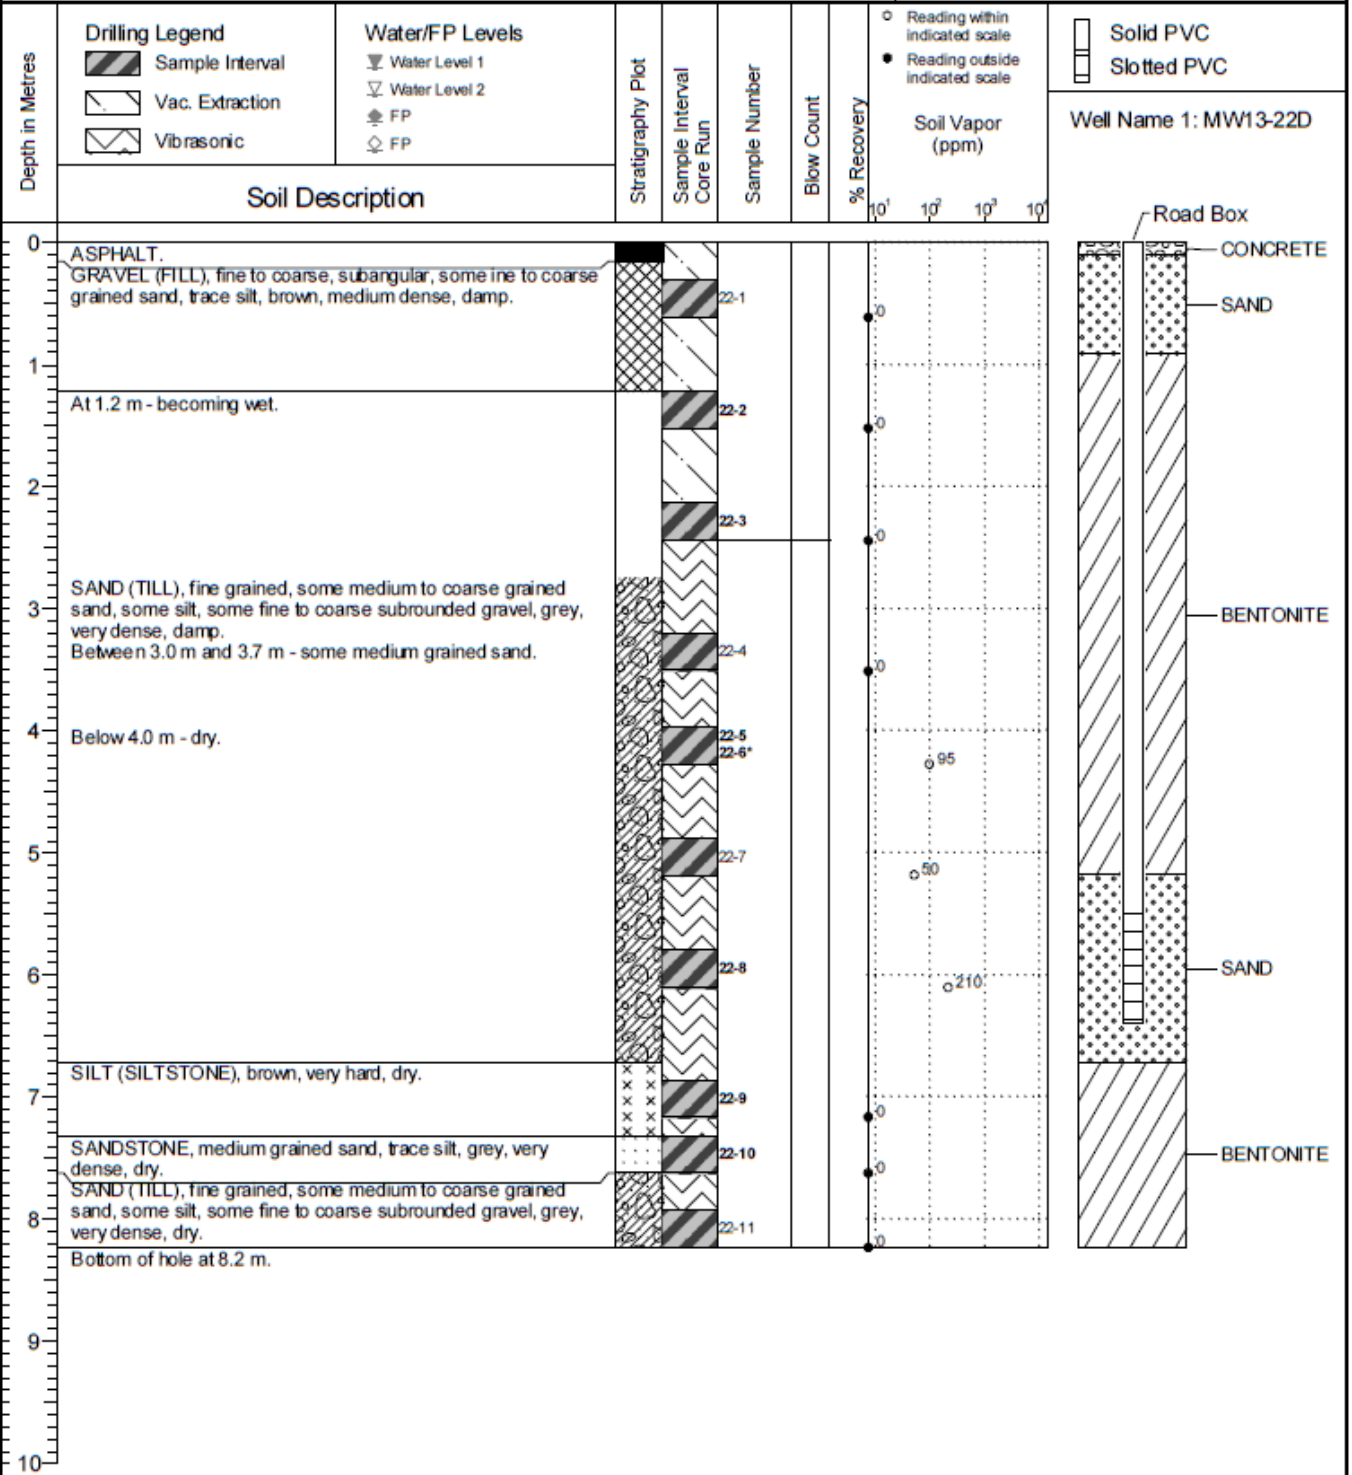

**NOTES**  
 Bolded sample denotes sample analyzed.  
 \* denotes blind field duplicate.

Print Date: 2013 08 01 QA1: JKR 2013 07 30