



Pottinger Gaherty  
Environmental Consultants Ltd.

# BOREHOLE LOG: BH6

(Page 1 of 1)


Client: Crest Services  
Site Address: 979 & 990 Adair Avenue,  
Coquitlam, BC

Installation Date : August 29, 2003  
Contractor : Beck Drilling  
Drill Type : Solid/Auger  
Logged By : Andrew Schmidt  
Well Installed : yes

Well Diameter : 2 inch  
Grade Elevation :  
Top of Piezo :

Project # 2094-01.02

Depth in Meters	USCS	GRAPHIC	DESCRIPTION	Samples	Sample Type	REMARKS
0			Grey, medium, SAND, some gravel, damp, fill			
0.5	FL					
1.0			Brown, PEAT, wet		Grab	
1.5	PT				Grab	
2.0			Grey, SILT, sandy, till, wet		Grab, Dup	
2.5	SW				Grab	
3.0			EOH @ 3.0m		Grab	

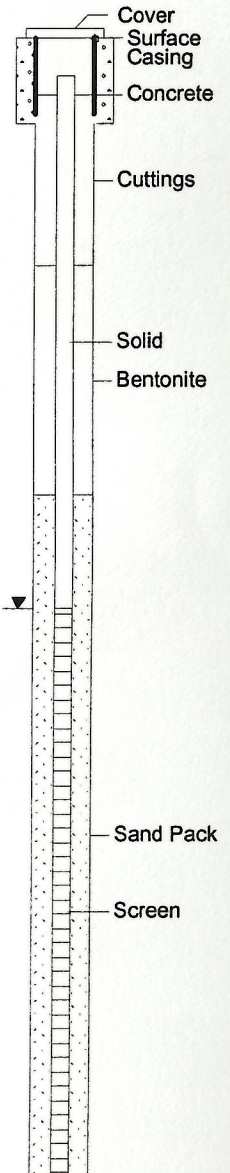

06-15-2004 T:\2000-2199\2094 CREST\01.04\BH6.BOR