

Log of Monitoring Well: MW15-2



Project Name/No: Mayfair/1411-004.05

Drilling Company: H2X Contracting Ltd./Drillwell Enterprises Ltd.

Client: Ivanhoe Cambridge

Drilling Method: Hydrovac/Auger

Date Drilled: October 15, 2015


Logged by: Jari Eikenaar

For Environmental Purposes Only

Site Location: 3147 Douglas Street, Victoria, BC

Sheet: 1 of 1

SUBSURFACE PROFILE				SAMPLE				Backfill details	
Depth	Symbol	Description	Depth/Elev (m)	Sample ID	Analysed Y,N	Sample Type	Vapour		LEL
							ppm		%
0		Ground Surface	0.00						
0		ASPHALT	0.00						
1		CLAY FILL Silty, some sand and gravel, some brick, grey to dark grey, medium soft, moist to damp, organics odour							
2							71.42		
3	1			15-2-01		G			
4									
5									
6				15-2-02		G	396.4		
7	2								
8		Some wood waste from 2.43 to 3.04 m							
9				15-2-03			399.8		
10	3								
11									
12									
13	4	SILT Grey, medium soft	-3.81 3.81	15-2-04			308		
14									
15	5								
16									
17									
18									
19									
20	6		-6.10 6.10						
21		End of Log							
22		Any use which a third party makes of this document, or any reliance on or decisions to be made based on it, are the responsibility of such third party. CSAP/MOE are not responsible for any use or modification of this document. CSAP/MOE accept no responsibility for damages, if any, suffered by any third party as a result of decisions made or actions taken based on this document.							
23	7								
24									
25									

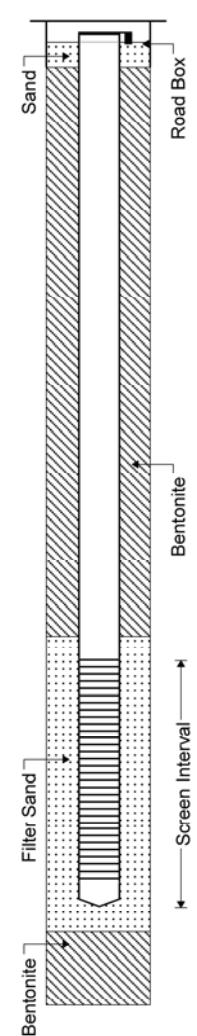

Well location: Location B	Well casing diameter: 0.051 m	Depth of well (TOC): 5.48 m
Depth to water level (TOC):	Well casing material: Schedule 40 PVC	Well Elevation (TOC): Not Surveyed
Date of water level:	Well screen slot size: 10 Slot	Ground Elevation: Not Surveyed
Borehole diameter: 0.152 m	Well screen interval (bgs): 3.96 to 5.48 m	